



NO.	REVISION	DATE	BY
2	MODULAR OFFICE PERMIT REVISION	04/03/95	OWNER
3	ISSUE FOR APPROVAL	04/25/95	RNS
4	ISSUED FOR ENG. REVIEW & BID	06/14/95	RNS
5	ISSUED FOR FINAL ENG. REVIEW	08/08/95	RNS
6	ISSUED FOR ADMIN. OFFICE PERMIT	09/26/95	RNS
7	ISSUED FOR ADMIN. OFFICE PERMIT	10/10/95	RNS
8	RECORD SET	11/28/06	WJL

Revised 1/9/08 by JMMcL © AKE, Inc to show placement of drums in CSA I and CSA II. This required the addition of the curb in CSA I. In CSA II, the E-W width was increased to 65.42 ft to match measurements, and the N-S width reduced to 100.0 ft to match measurements. Also in CSA II, the south ramp was added to the east wall and the ramps in the NW and SW corners were increased in width to 15.58 ft. to match the surveyed points.

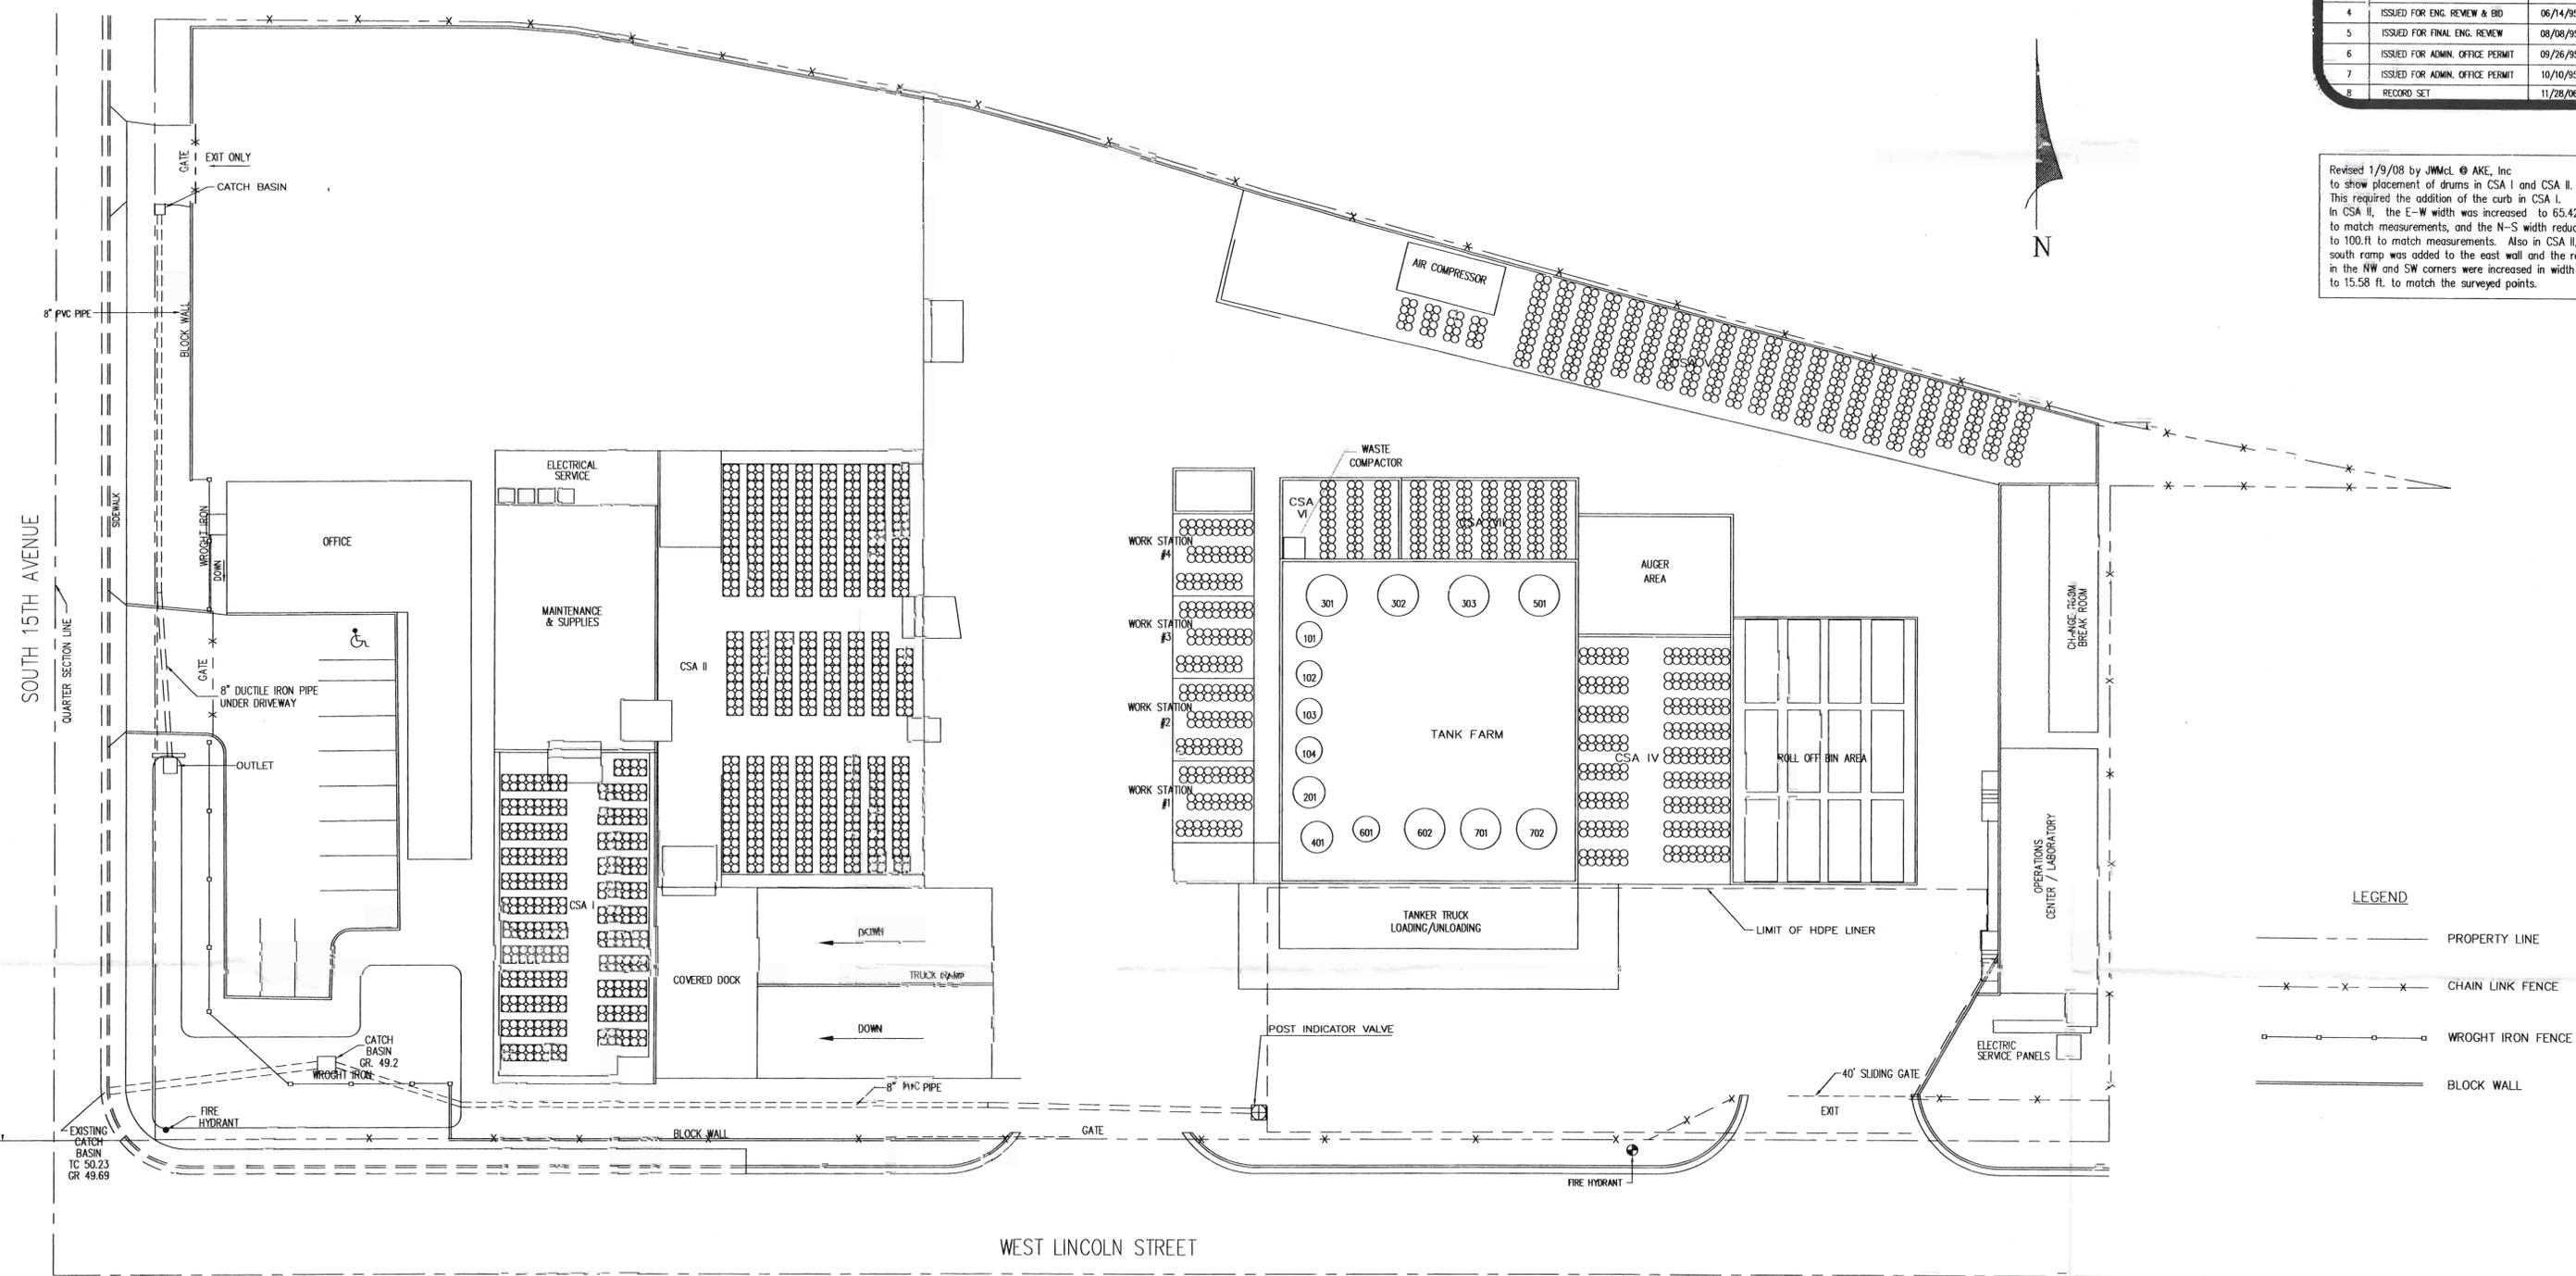

**LEGEND**

-----	PROPERTY LINE
-x-x-x-	CHAIN LINK FENCE
o-o-o-o	WROUGHT IRON FENCE
=====	BLOCK WALL

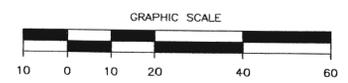

RECORD SET

VISIBLE ELEMENTS  
VERIFIED BY AKE, INC.  
*Davis R*  
11/1/08

CleanHarbors®

THIS DRAWING IS THE PROPERTY OF CLEAN HARBORS. ANY INFORMATION CONTAINED THEREON MAY NOT BE COPIED OR USED WITHOUT WRITTEN PERMISSION OF OWNER.

FACILITY PLAN

CLEAN HARBORS ENVIRONMENTAL SERVICES  
1340 WEST LINCOLN STREET  
PHOENIX, ARIZONA  
PHONE: (602) 258-6155 FAX: (602) 258-8353

DRW. BY: BOB	DATE: 11/21/94	CADD NO: FP1
DSG. BY:	DATE:	PROJECT NO: 1513
APP. BY:	DATE:	DWG. No.
SCALE: 1" = 20'		FP1