


APPENDIX E
BP-SERIES WELL CONSTRUCTION DIAGRAMS
REMEDIAL INVESTIGATION REPORT
GROUNDWATER OPERABLE UNIT
Arizona Department of Environmental Quality
Broadway-Pantano Water Quality Assurance Revolving Fund Site
June 1, 2012

AS-BUILT GROUNDWATER MONITOR WELL

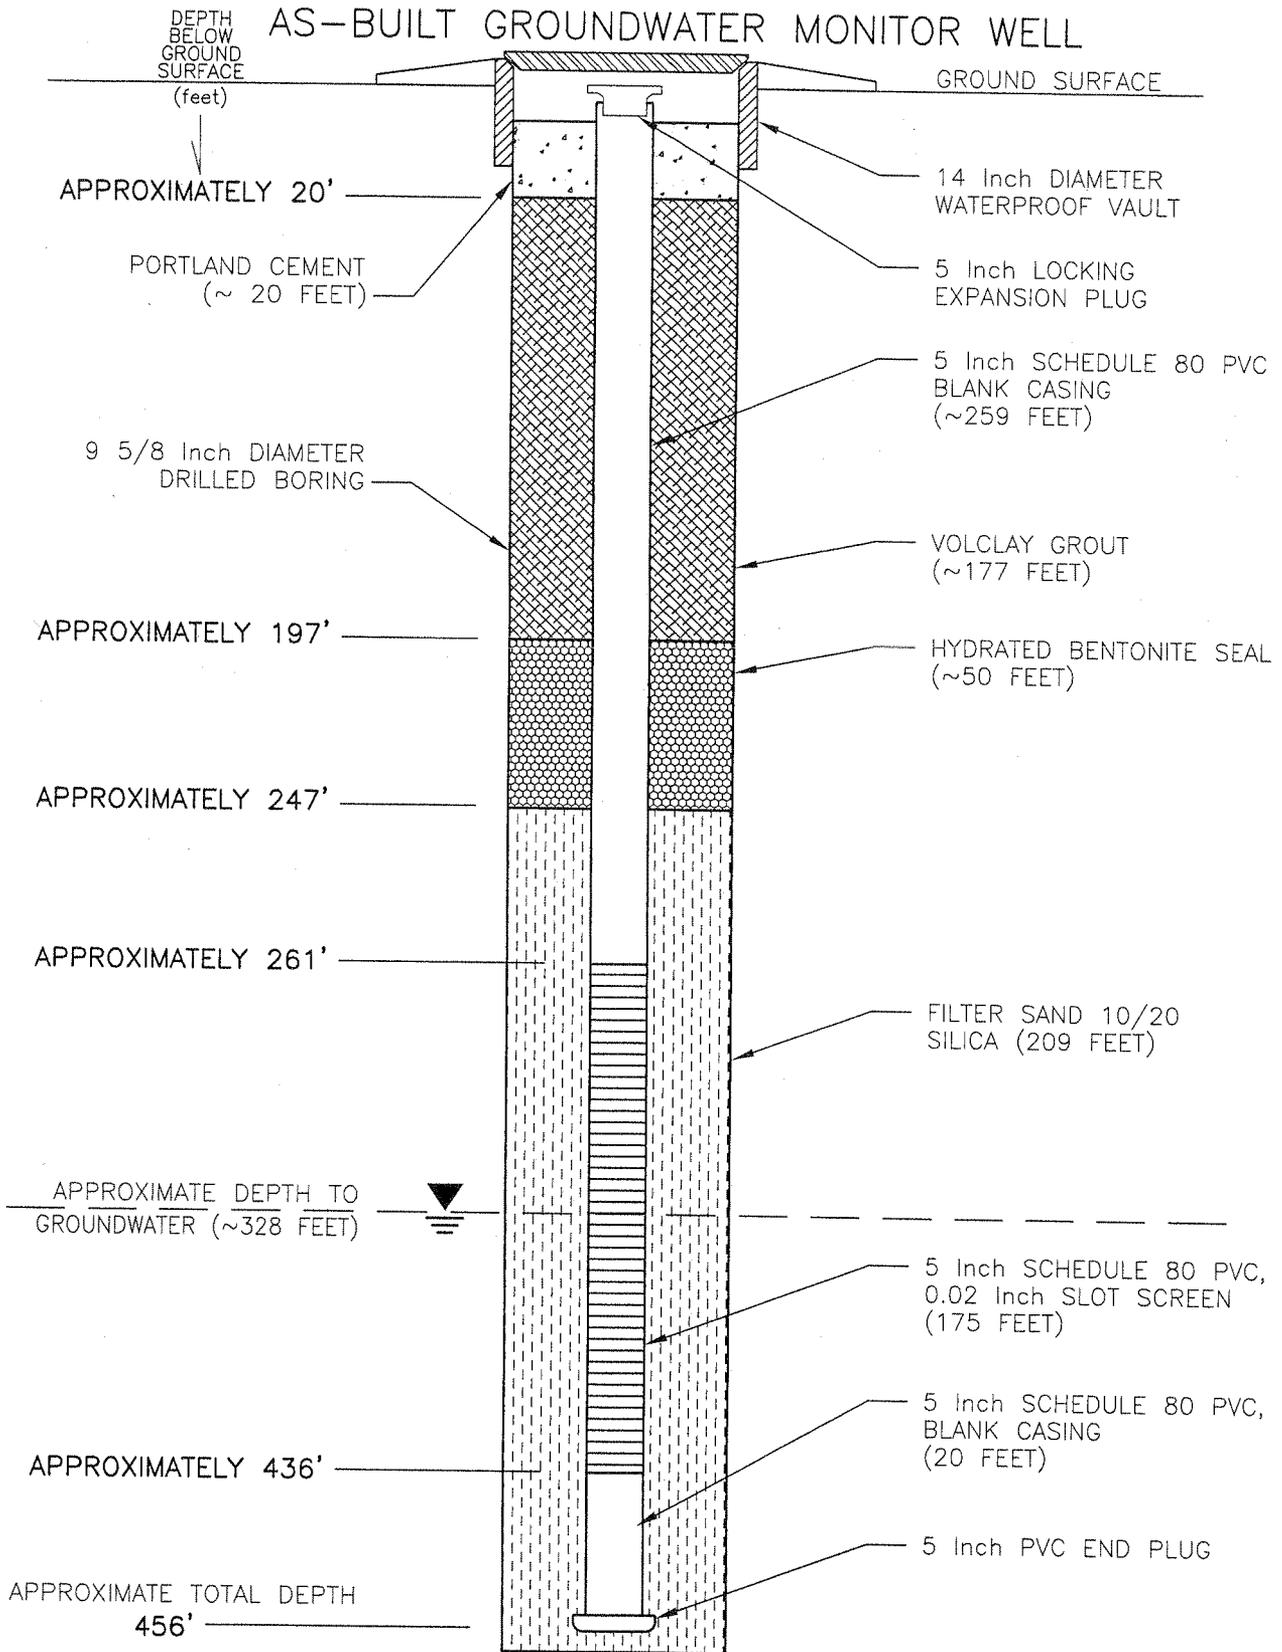


NOT TO SCALE

SECOR INTERNATIONAL
INCORPORATED
1830 WEST UNIVERSITY, SUITE 106
PHOENIX, ARIZONA 85281

WELL CONSTRUCTION DIAGRAM
(BP-1)
BROADWAY-PANTANO WQARF SITE
TUCSON, ARIZONA

FIGURE: **E-1**
DATE: 01/17/02
PROJECT NO:
018.20401.021

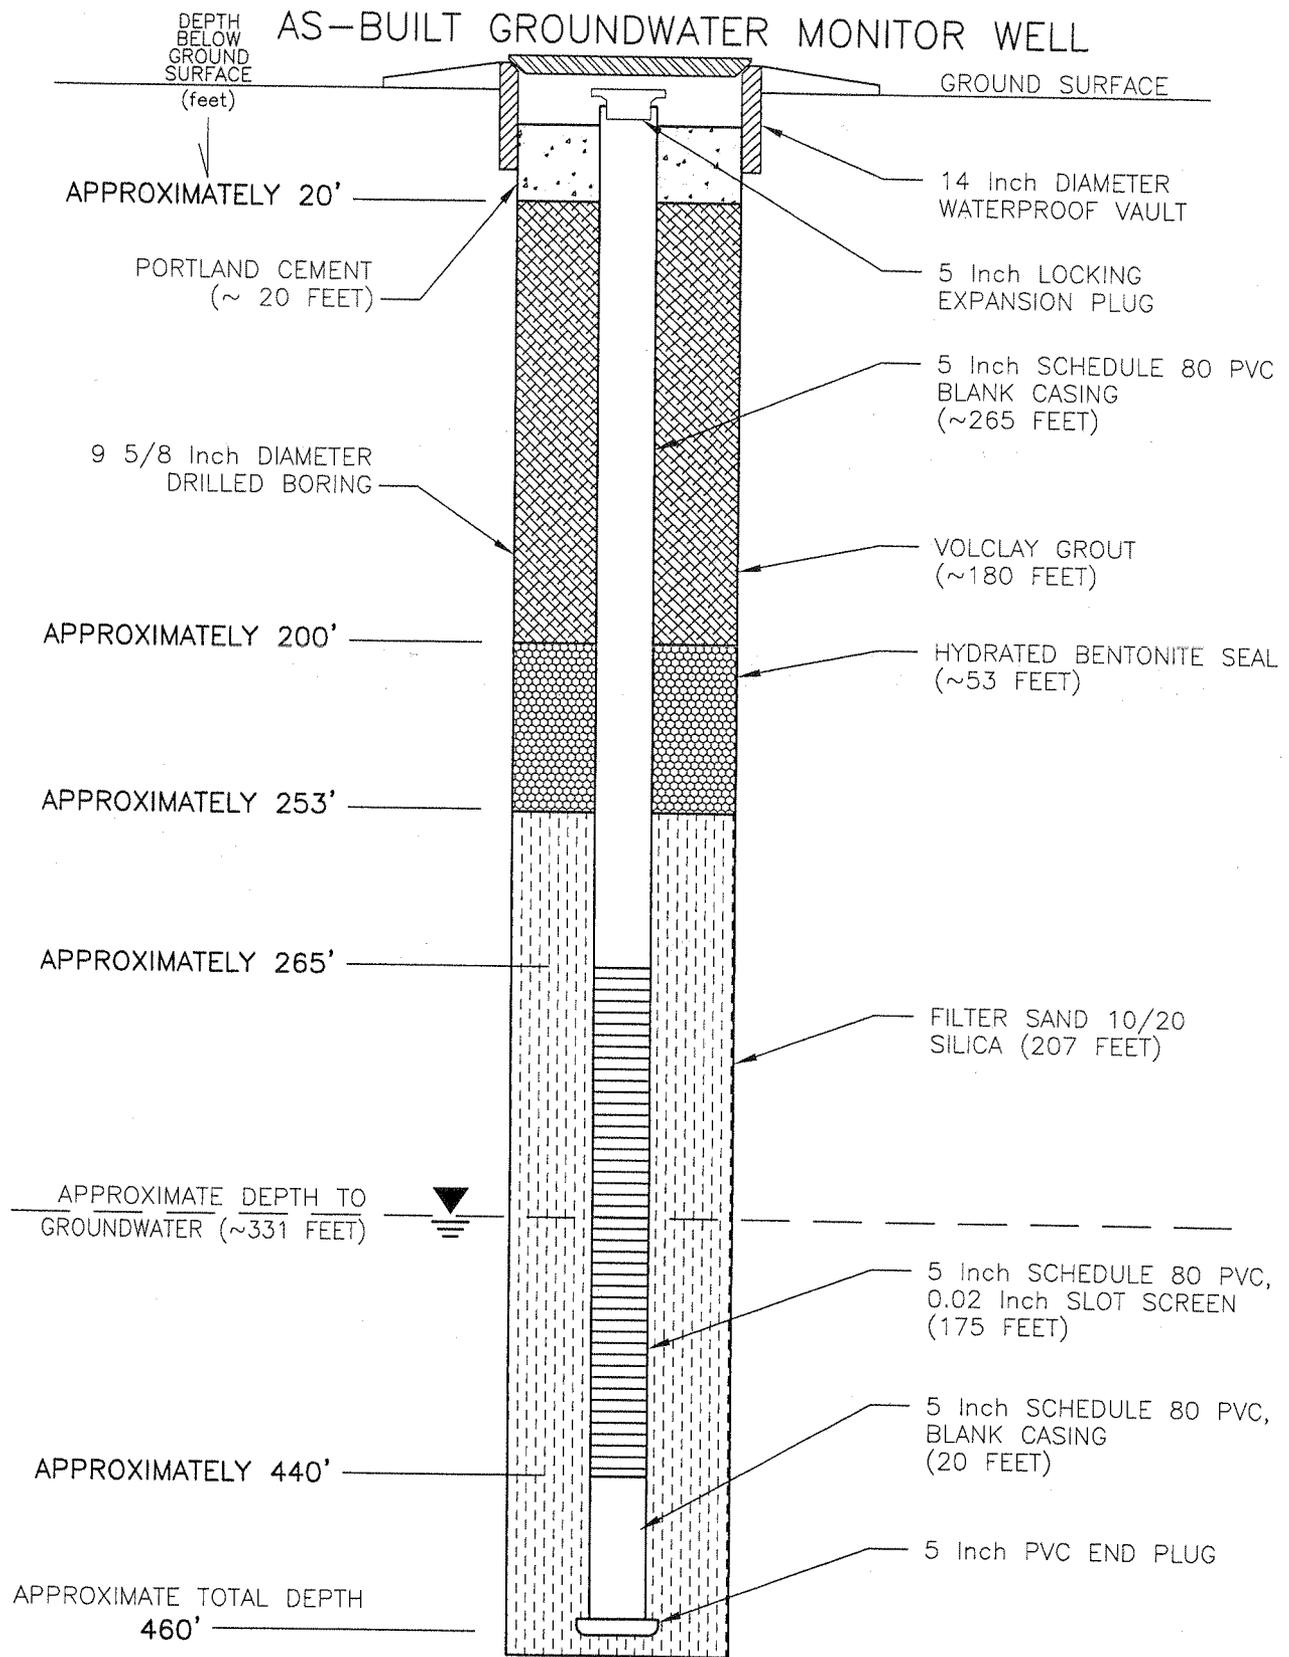


NOT TO SCALE

SECOR INTERNATIONAL
INCORPORATED
1830 WEST UNIVERSITY, SUITE 106
PHOENIX, ARIZONA 85281

WELL CONSTRUCTION DIAGRAM
(BP-2)
BROADWAY-PANTANO WQARF SITE
TUCSON, ARIZONA

FIGURE: **E-2**
DATE: 01/08/02
PROJECT NO:
018.20401.021

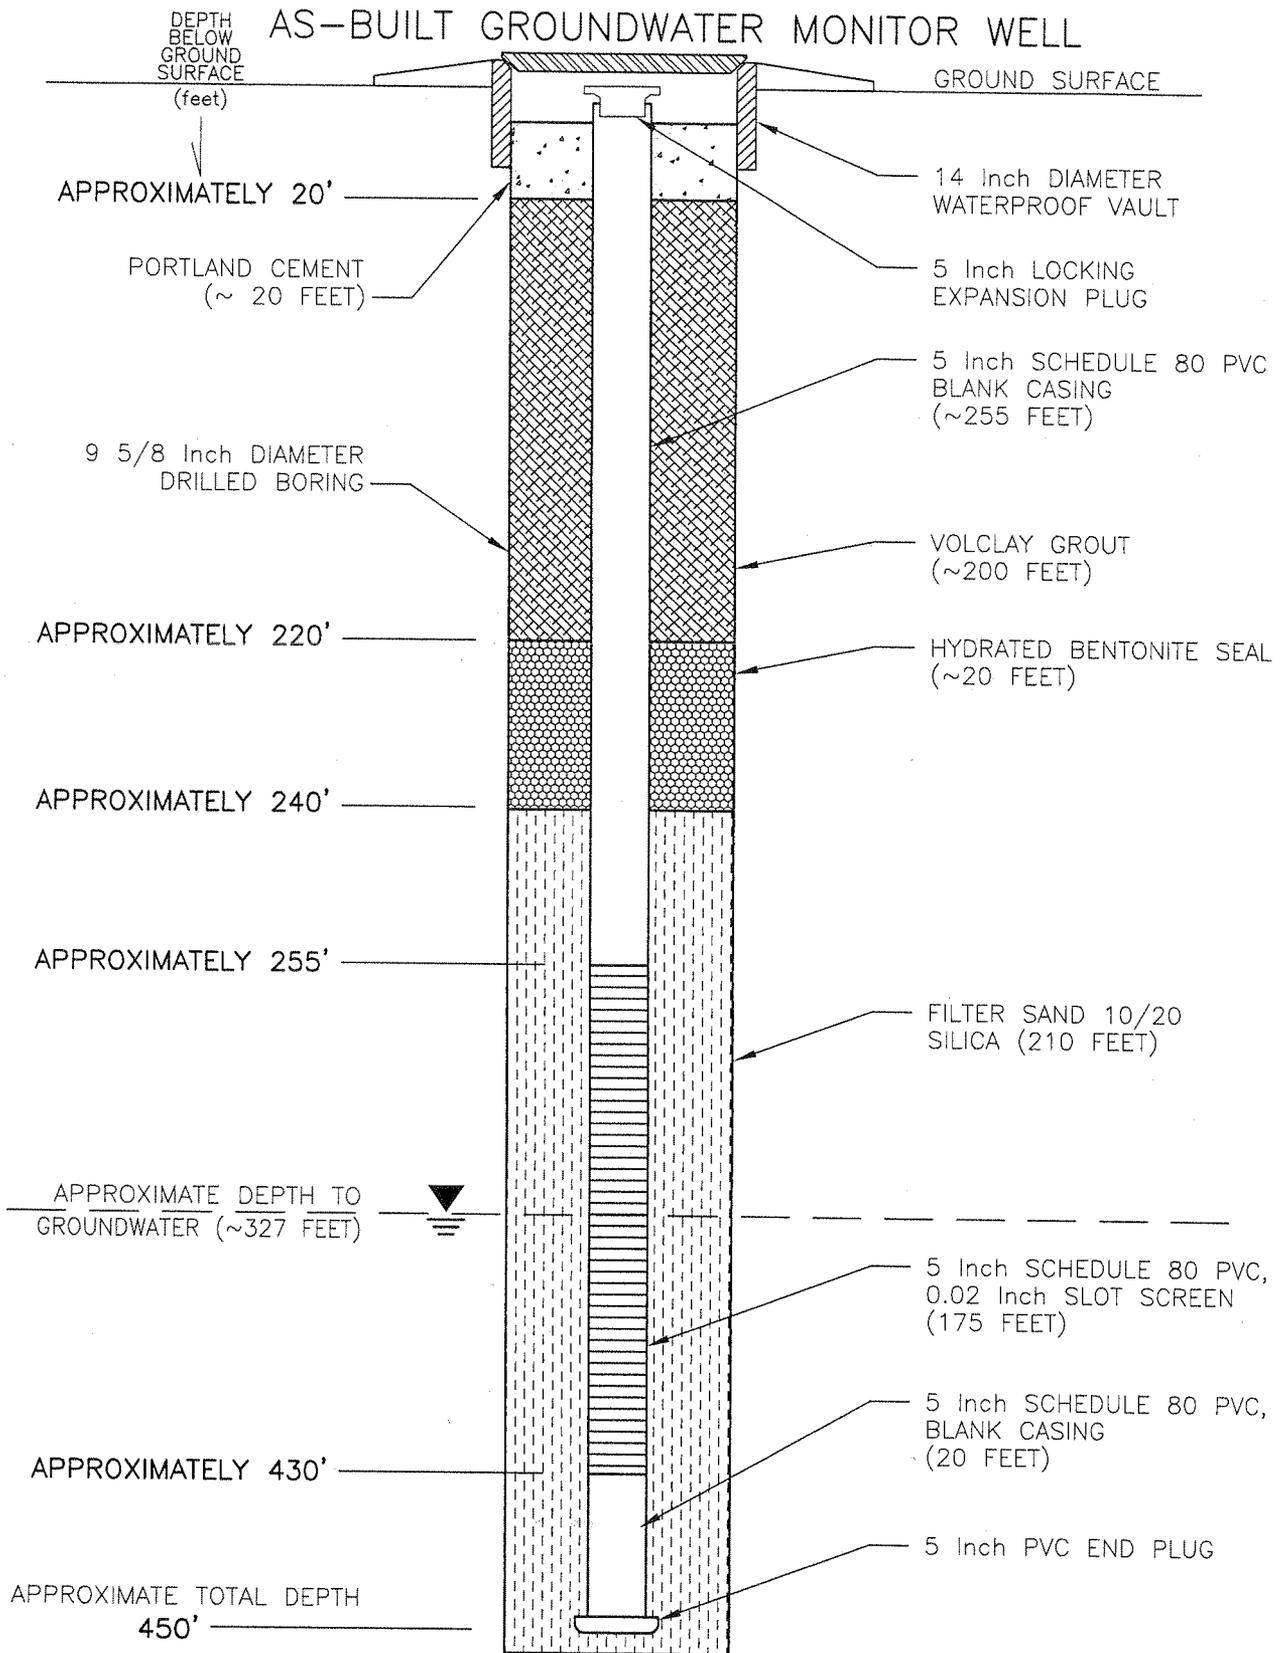


NOT TO SCALE

SECOR INTERNATIONAL
INCORPORATED
1830 WEST UNIVERSITY, SUITE 106
PHOENIX, ARIZONA 85281

WELL CONSTRUCTION DIAGRAM
(BP-3)
BROADWAY-PANTANO WQARF SITE
TUCSON, ARIZONA

FIGURE: **E-3**
DATE: 07/09/02
PROJECT NO:
180T.20401.00.0021

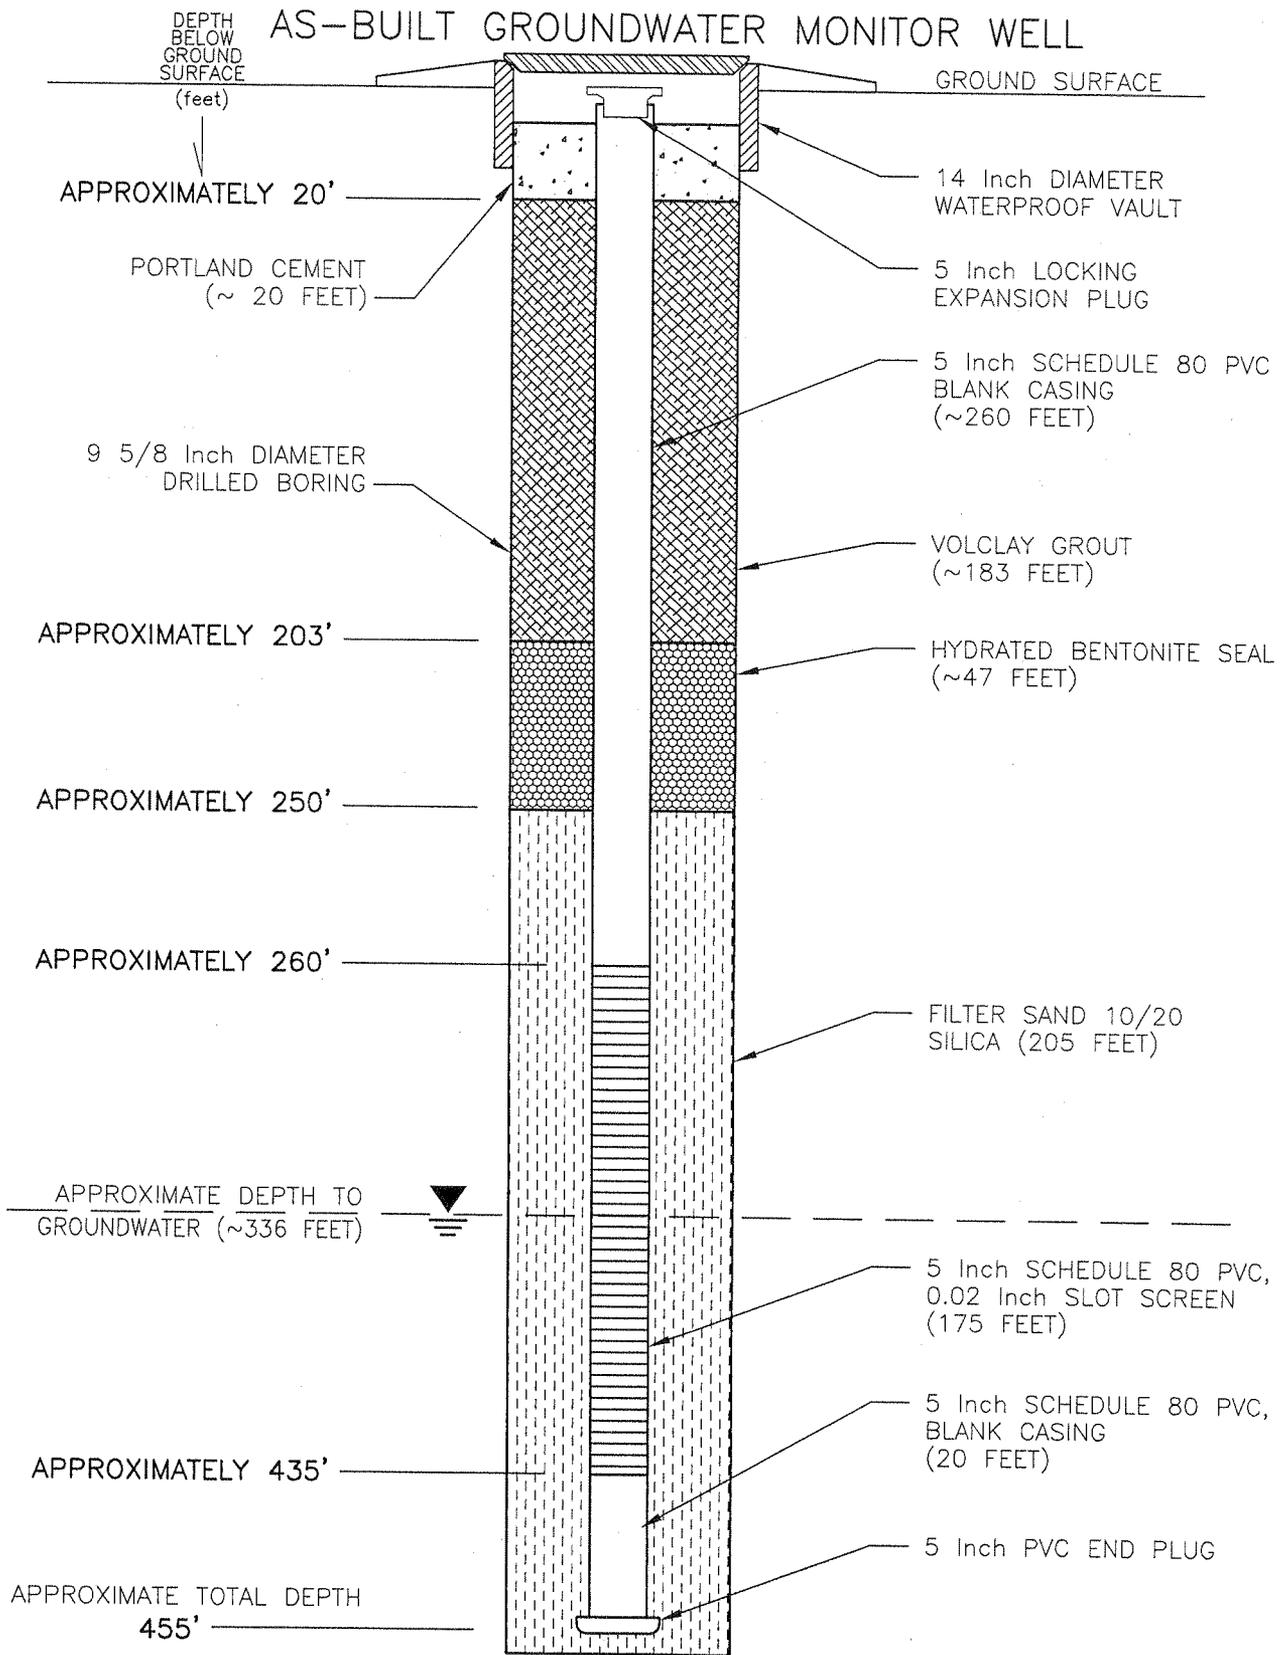


NOT TO SCALE

SECOR INTERNATIONAL
INCORPORATED
1830 WEST UNIVERSITY, SUITE 106
PHOENIX, ARIZONA 85281

WELL CONSTRUCTION DIAGRAM
(BP-4)
BROADWAY-PANTANO WQARF SITE
TUCSON, ARIZONA

FIGURE: **E-4**
DATE: 02/08/02
PROJECT NO:
018.20401.021

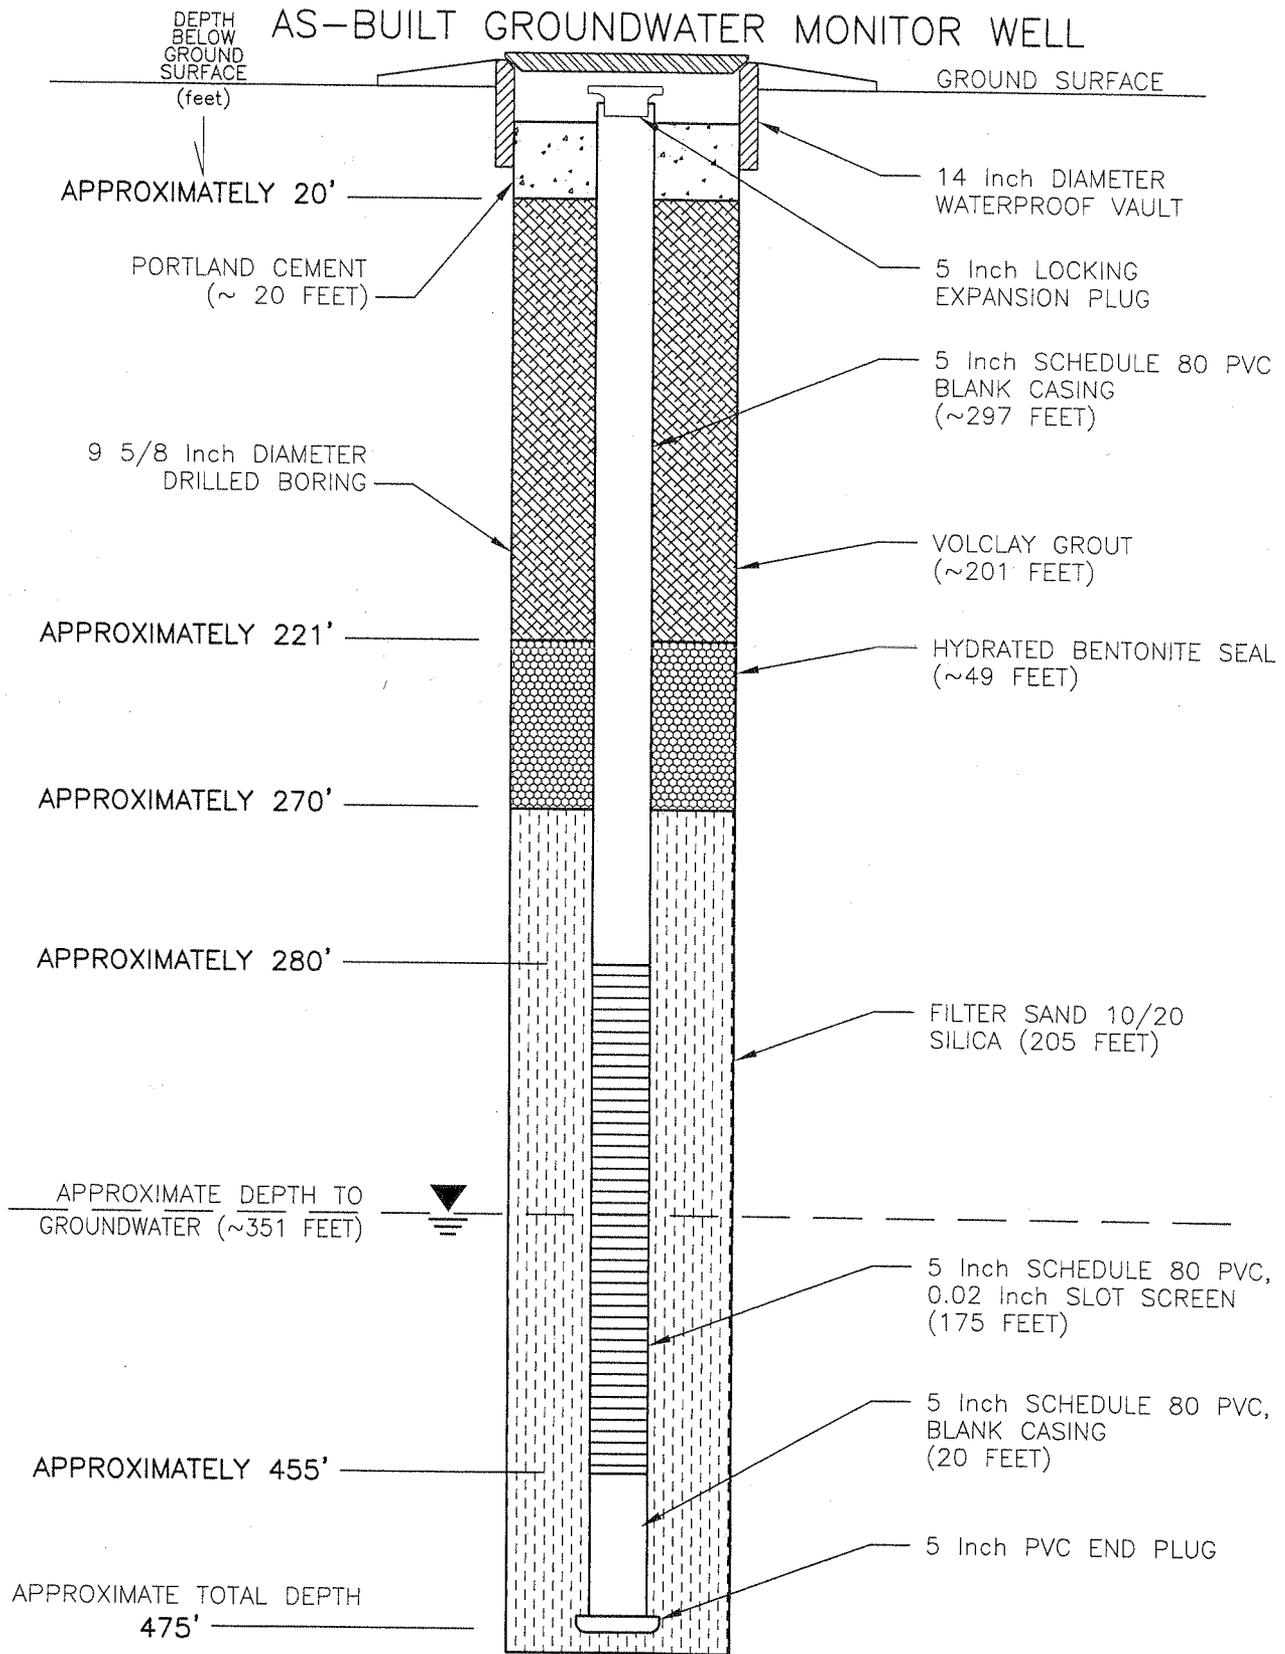


NOT TO SCALE

SECOR INTERNATIONAL
INCORPORATED
1830 WEST UNIVERSITY, SUITE 106
PHOENIX, ARIZONA 85281

WELL CONSTRUCTION DIAGRAM
(BP-5)
BROADWAY-PANTANO WQARF SITE
TUCSON, ARIZONA

FIGURE:	E-5
DATE:	01/17/02
PROJECT NO:	018.20401.021

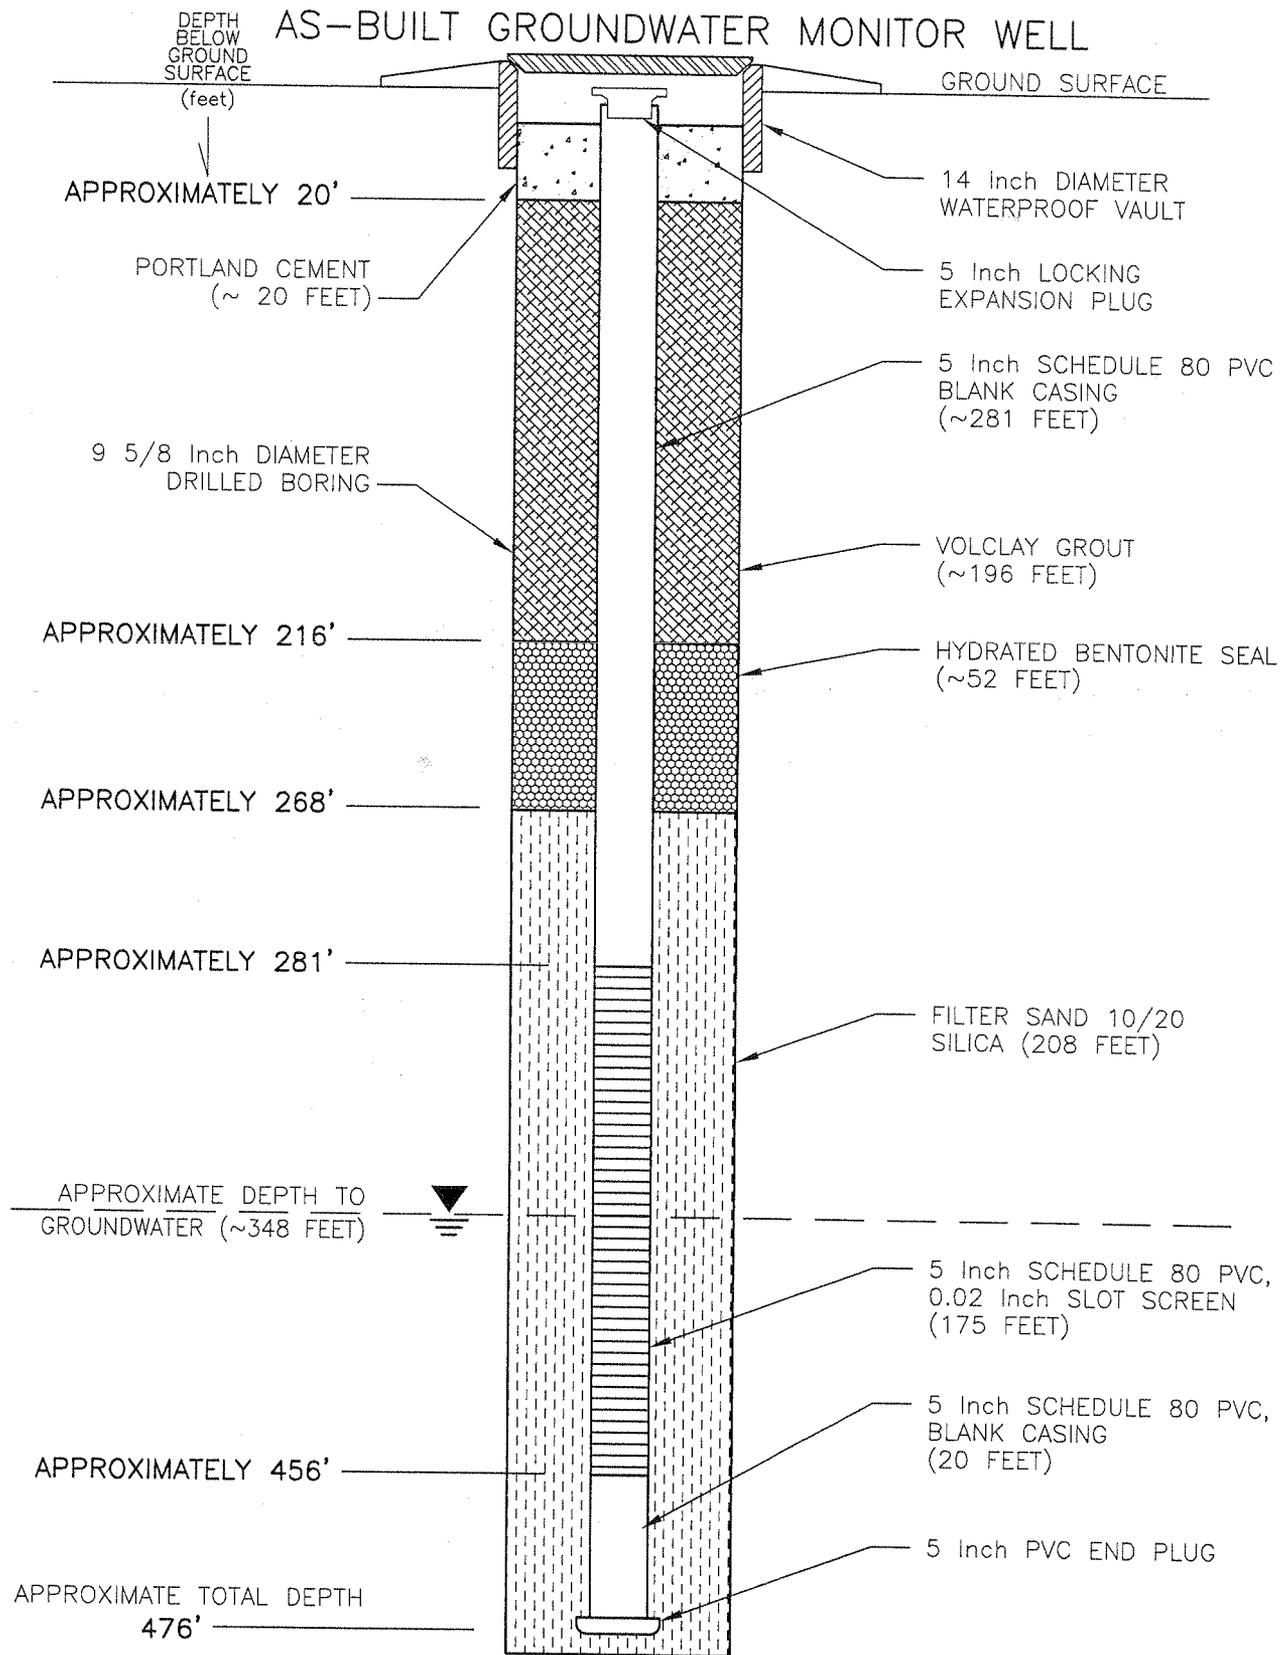


NOT TO SCALE

SECOR INTERNATIONAL
INCORPORATED
1830 WEST UNIVERSITY, SUITE 106
PHOENIX, ARIZONA 85281

WELL CONSTRUCTION DIAGRAM
(BP-7)
BROADWAY-PANTANO WQARF SITE
TUCSON, ARIZONA

FIGURE: **E-6**
DATE: 01/08/02
PROJECT NO:
018.20401.021

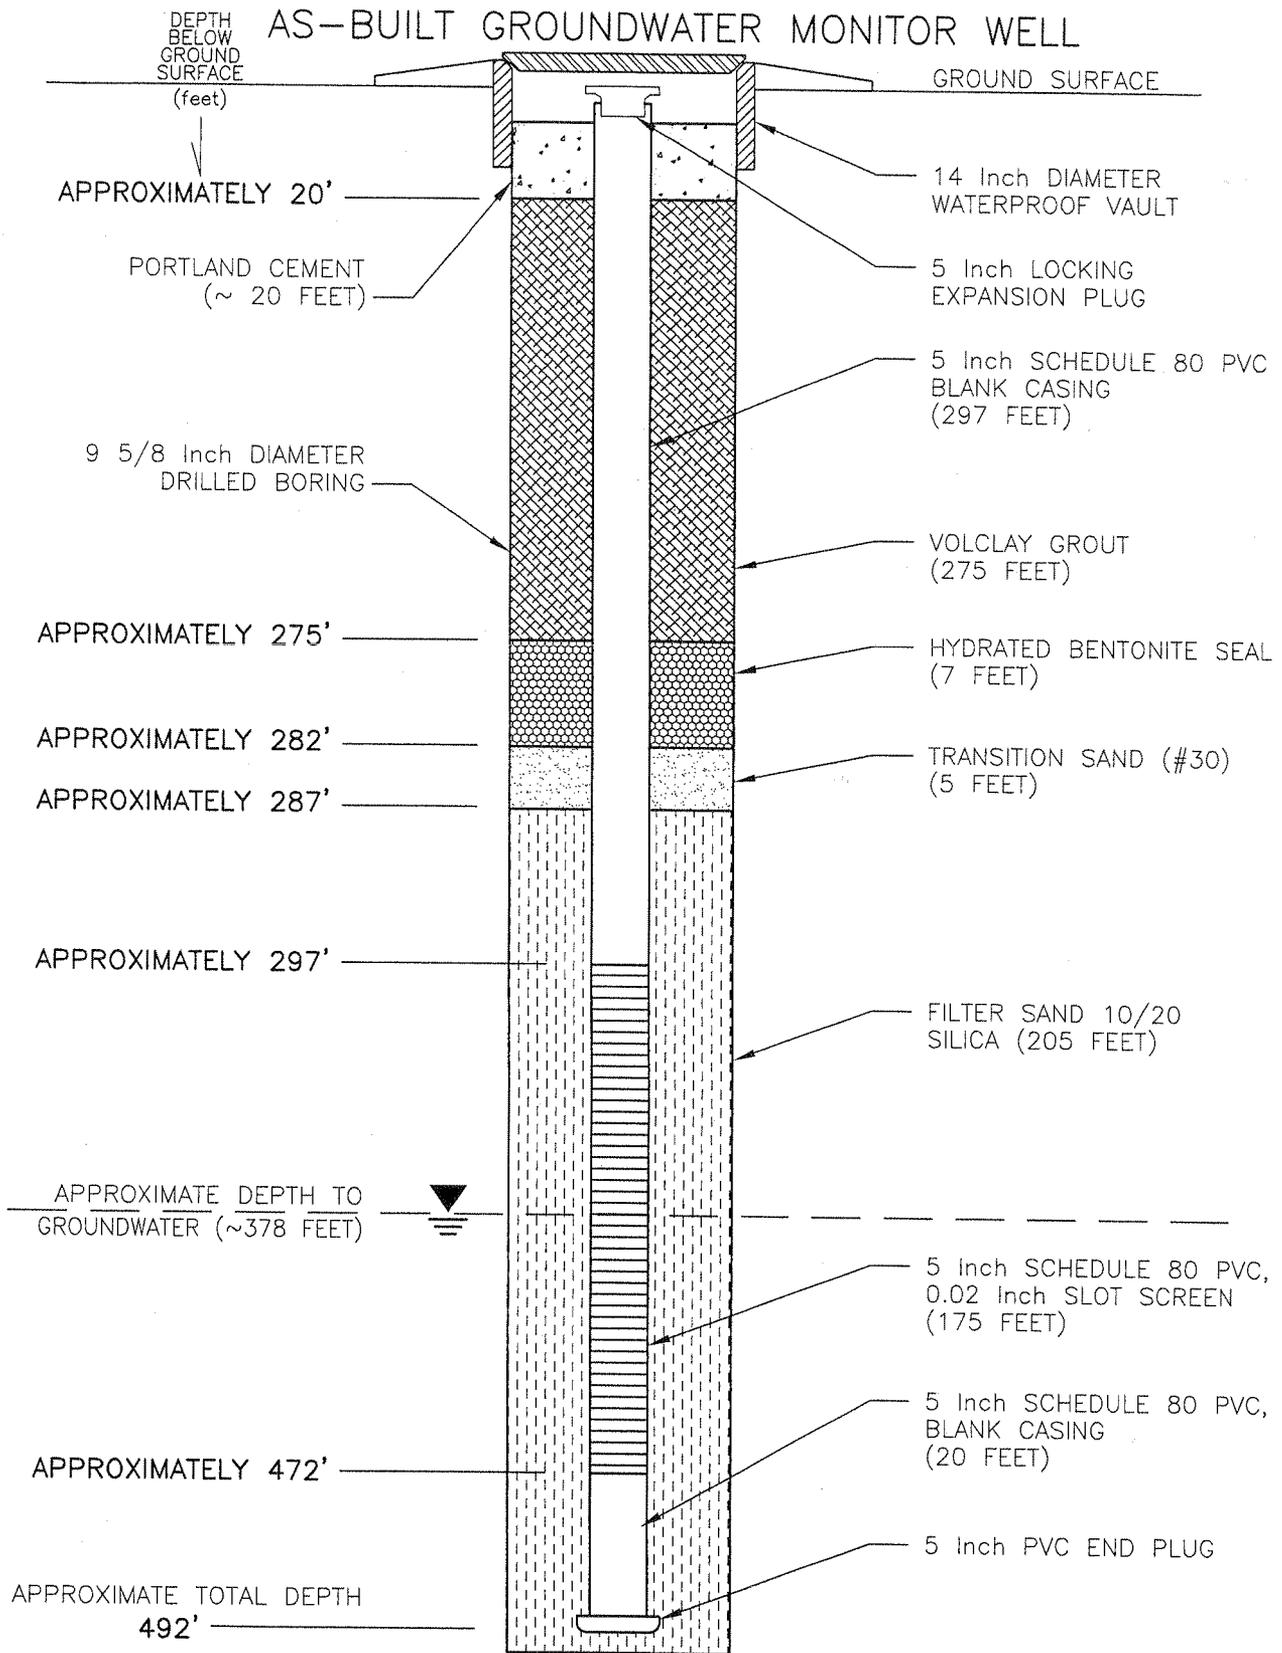


NOT TO SCALE

SECOR INTERNATIONAL
INCORPORATED

1830 WEST UNIVERSITY, SUITE 106
PHOENIX, ARIZONA 85281

WELL CONSTRUCTION DIAGRAM
K-MART WELL (BP-8)
BROADWAY-PANTANO WQARF SITE
TUCSON, ARIZONA

FIGURE: **E-7**
DATE: 01/08/02
PROJECT NO:
018.20401.021

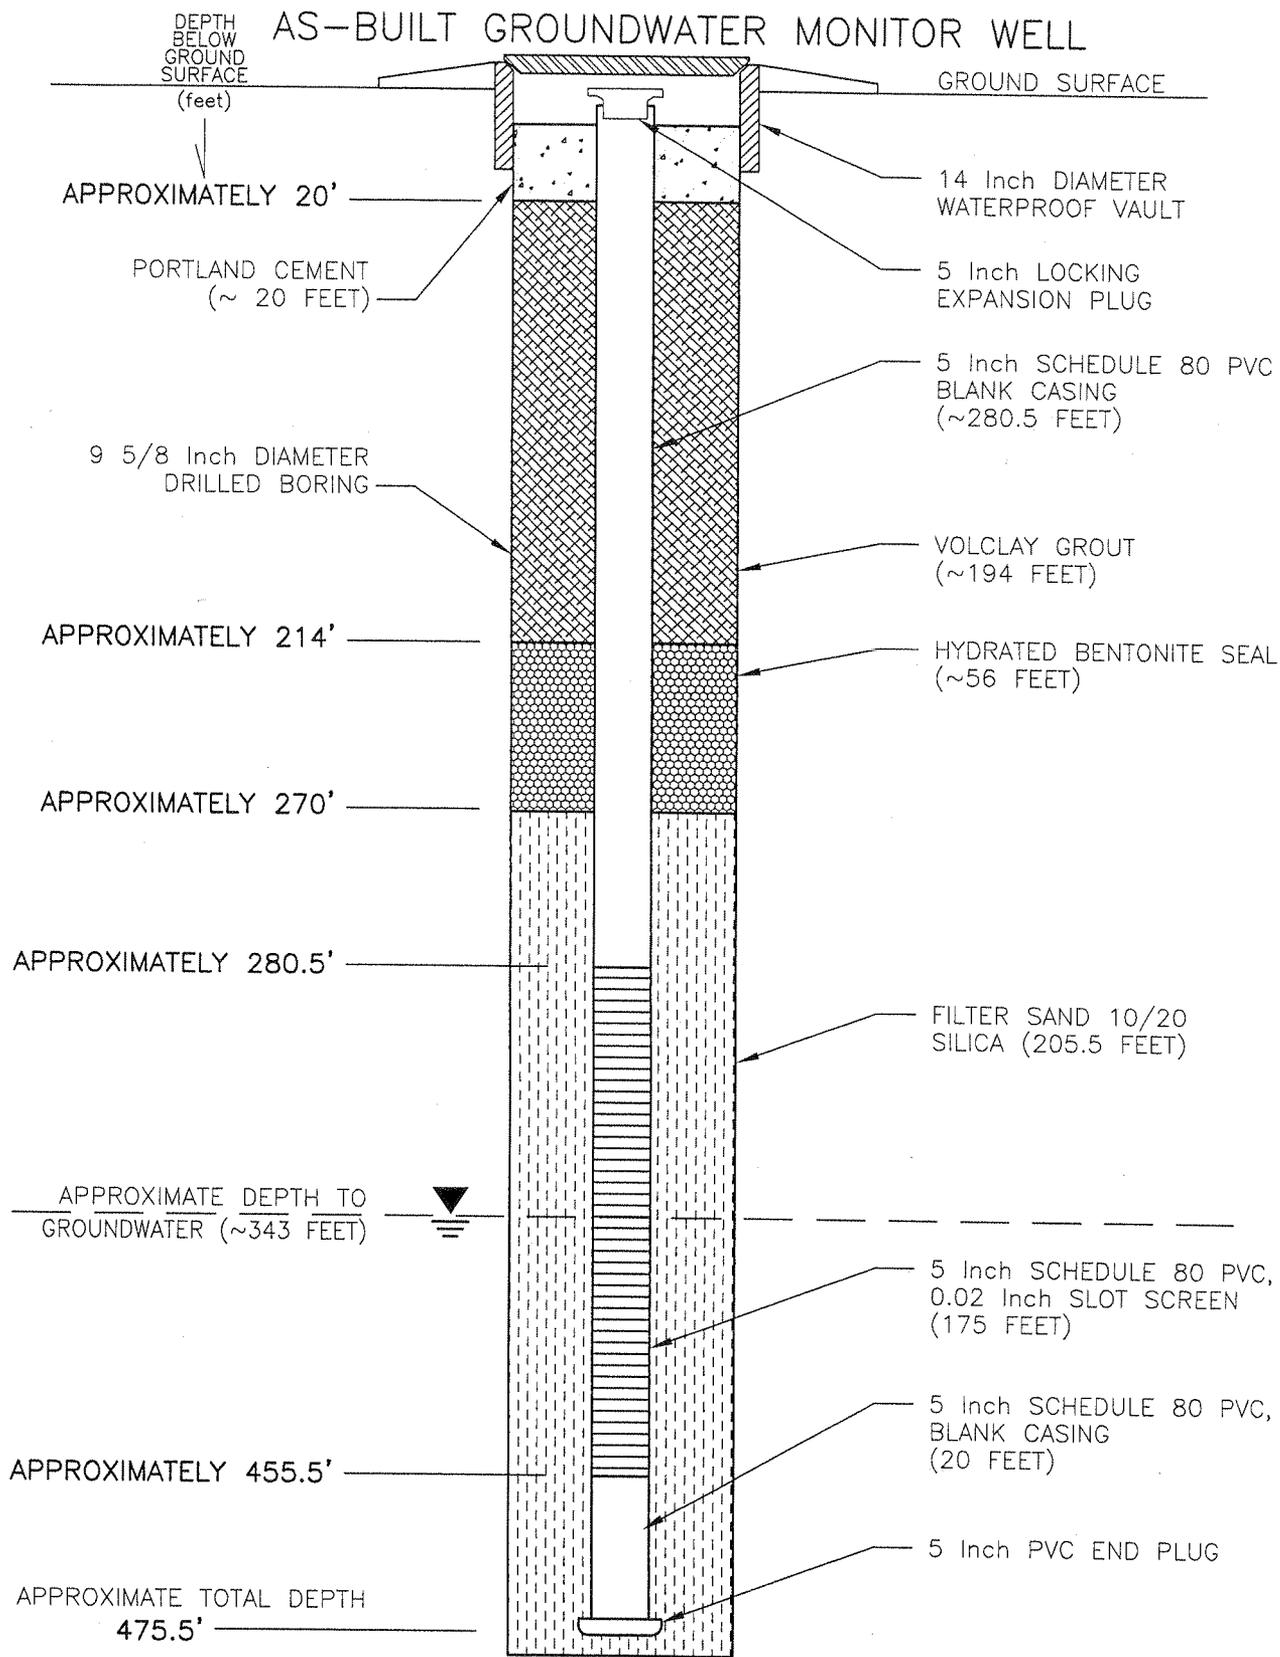


NOT TO SCALE

SECOR INTERNATIONAL
INCORPORATED
1830 WEST UNIVERSITY, SUITE 106
PHOENIX, ARIZONA 85281

WELL CONSTRUCTION DIAGRAM
(BP-9)
BROADWAY-PANTANO WQARF SITE
TUCSON, ARIZONA

FIGURE: **E-8**
DATE: 01/08/02
PROJECT NO:
018.20401.021

AS-BUILT GROUNDWATER MONITOR WELL

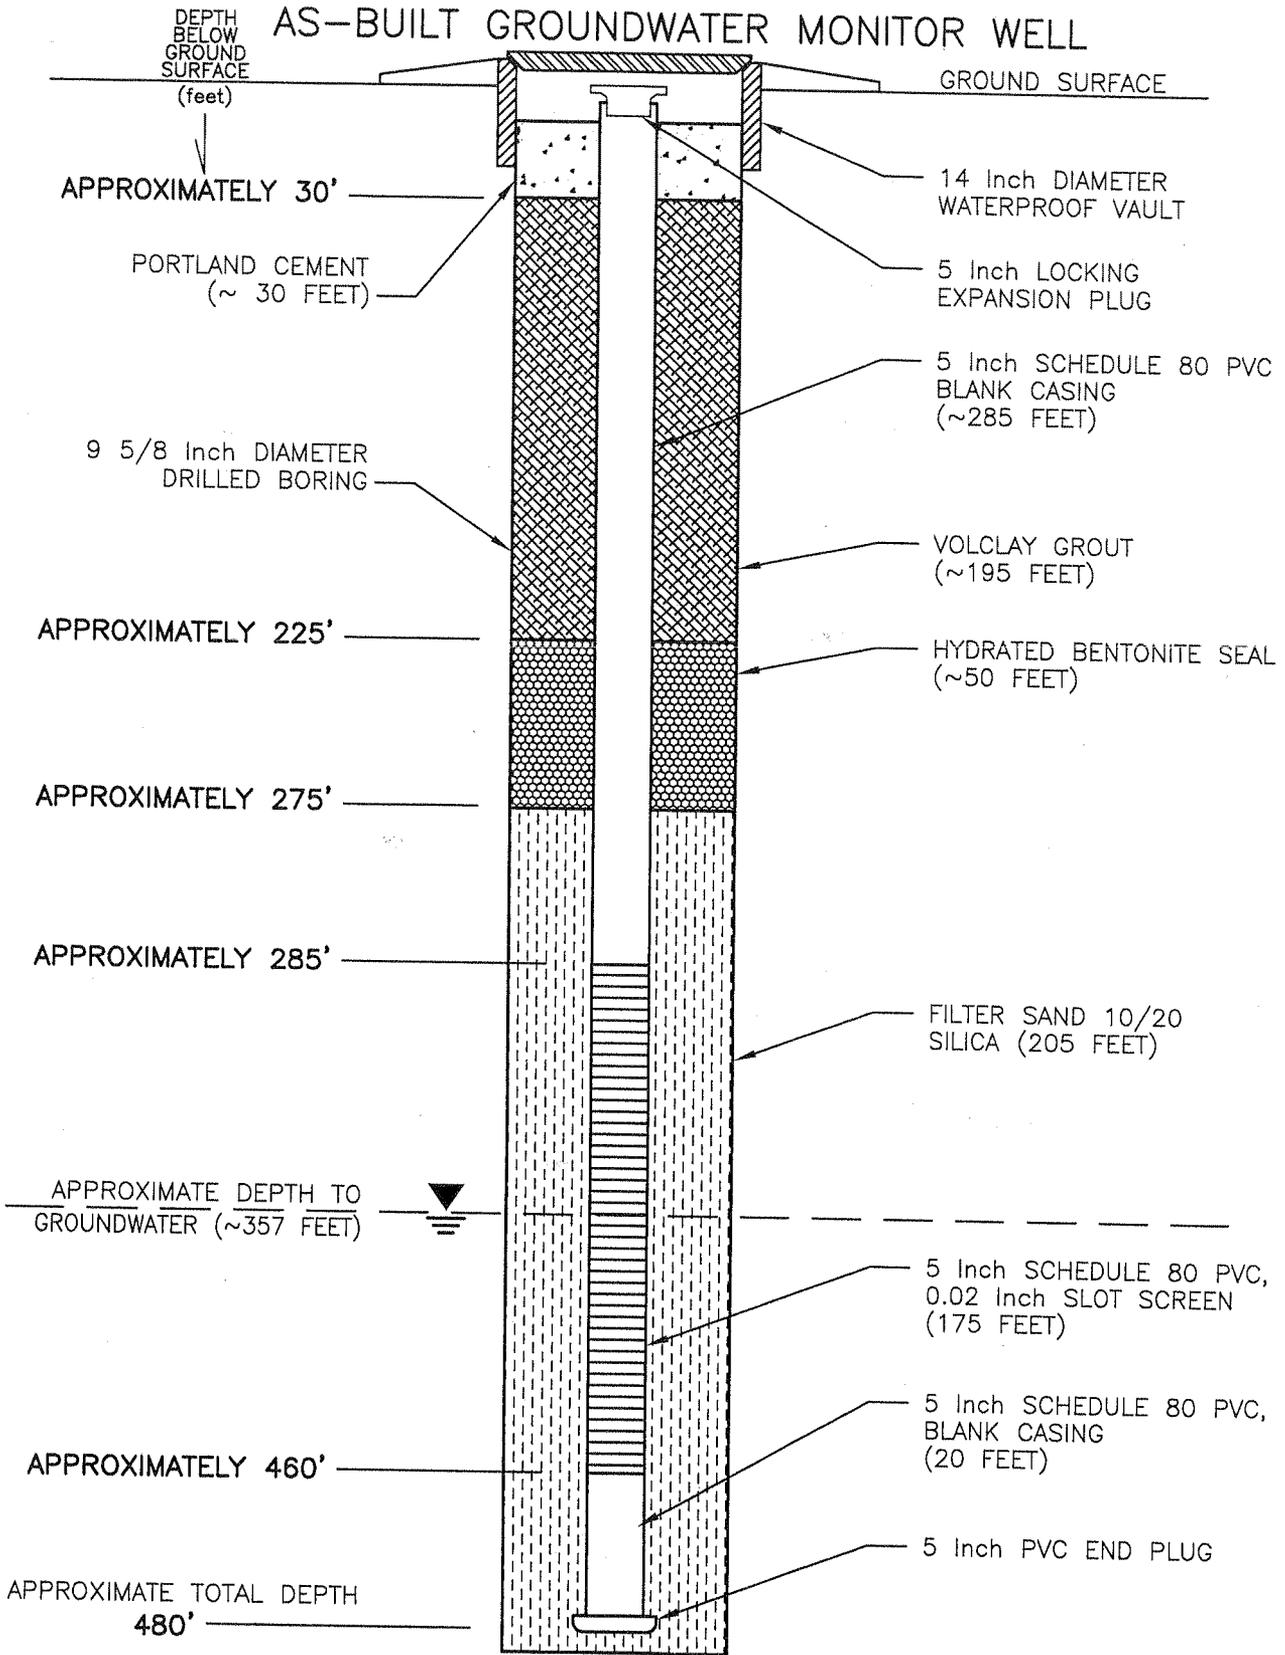


NOT TO SCALE

SECOR INTERNATIONAL
INCORPORATED
1830 WEST UNIVERSITY, SUITE 106
PHOENIX, ARIZONA 85281

WELL CONSTRUCTION DIAGRAM
(BP-10)
BROADWAY-PANTANO WQARF SITE
TUCSON, ARIZONA

FIGURE: **E-9**
DATE: 01/08/02
PROJECT NO:
018.20401.021

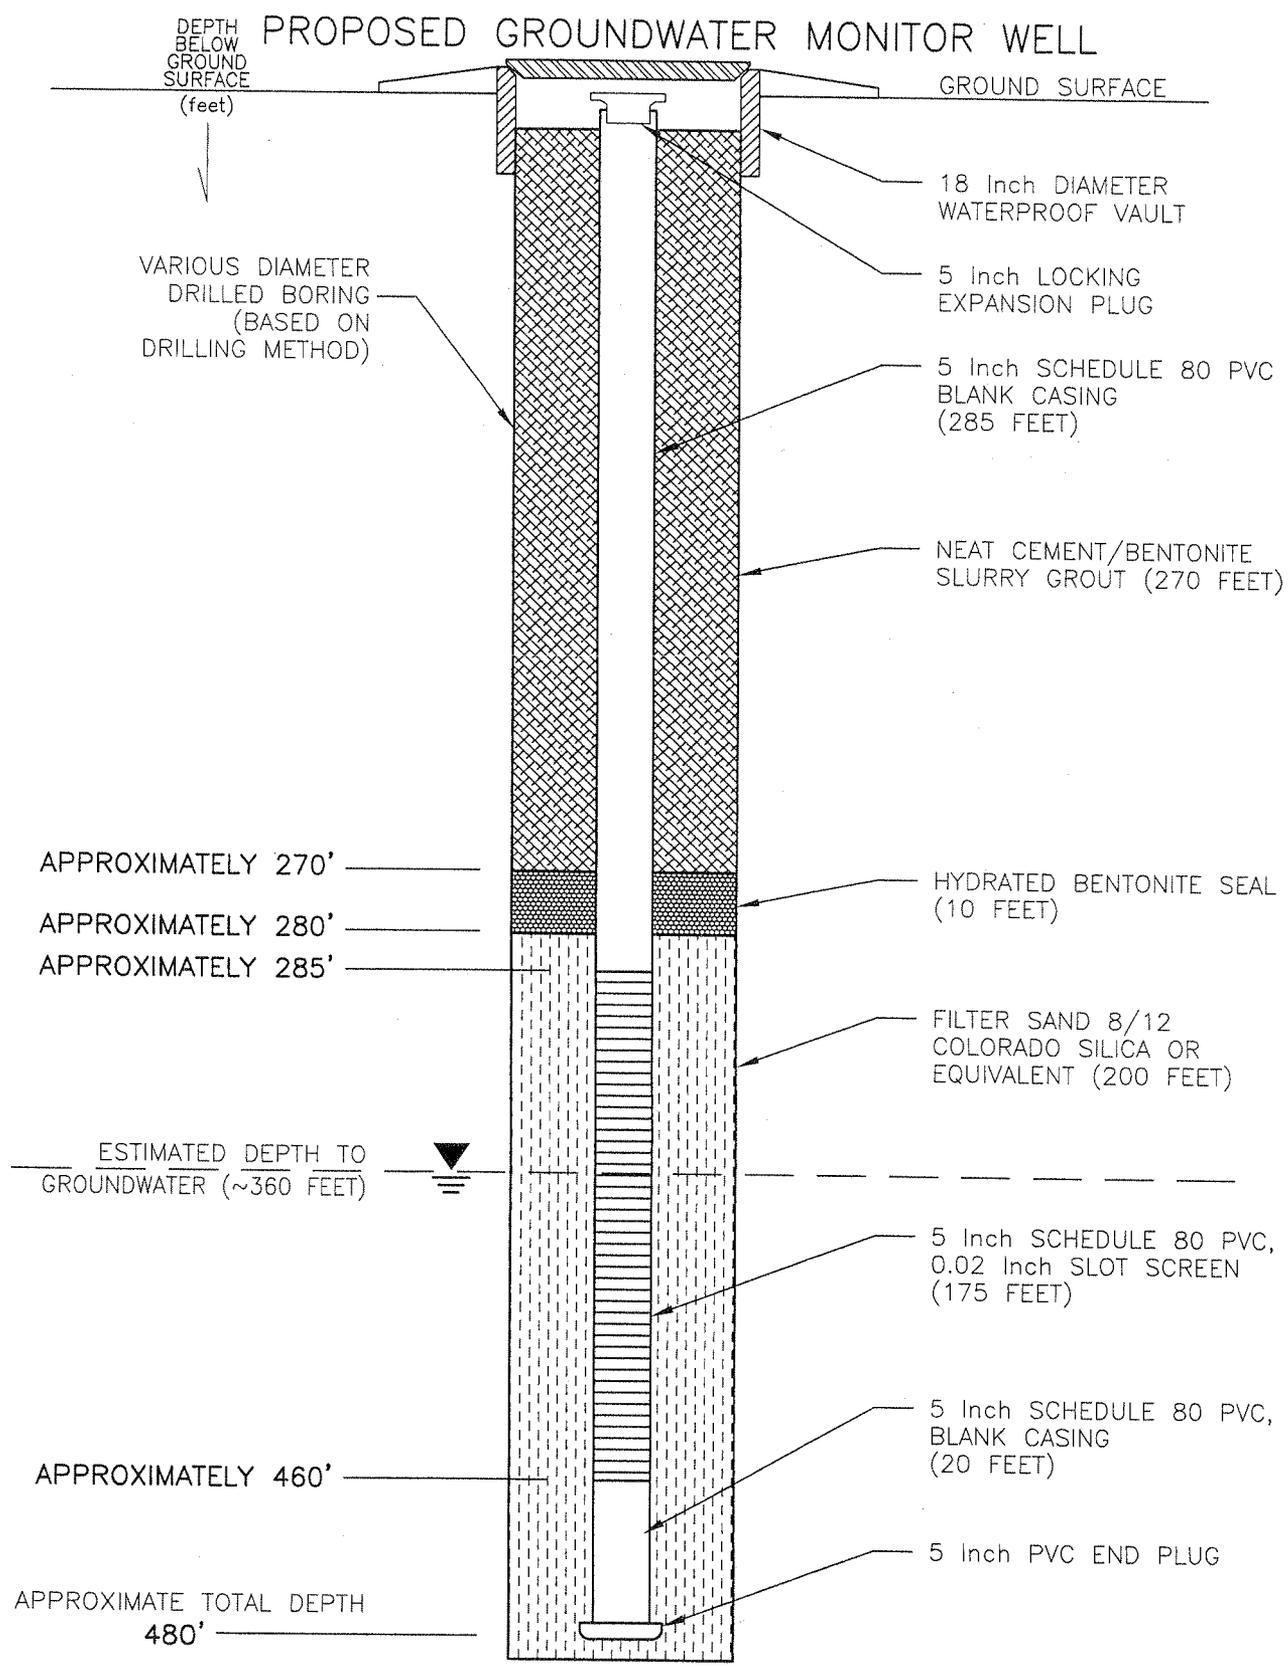


NOT TO SCALE

SECOR INTERNATIONAL INCORPORATED
 1830 WEST UNIVERSITY, SUITE 106
 PHOENIX, ARIZONA 85281

WELL CONSTRUCTION DIAGRAM
 BROADWAY SOUTH LANDFILL (BP-11)
 BROADWAY-PANTANO WQARF SITE
 TUCSON, ARIZONA

FIGURE: **E-10**
 DATE: 07/27/01
 PROJECT NO: 018.20401.015

AS-BUILT GROUNDWATER MONITOR WELL

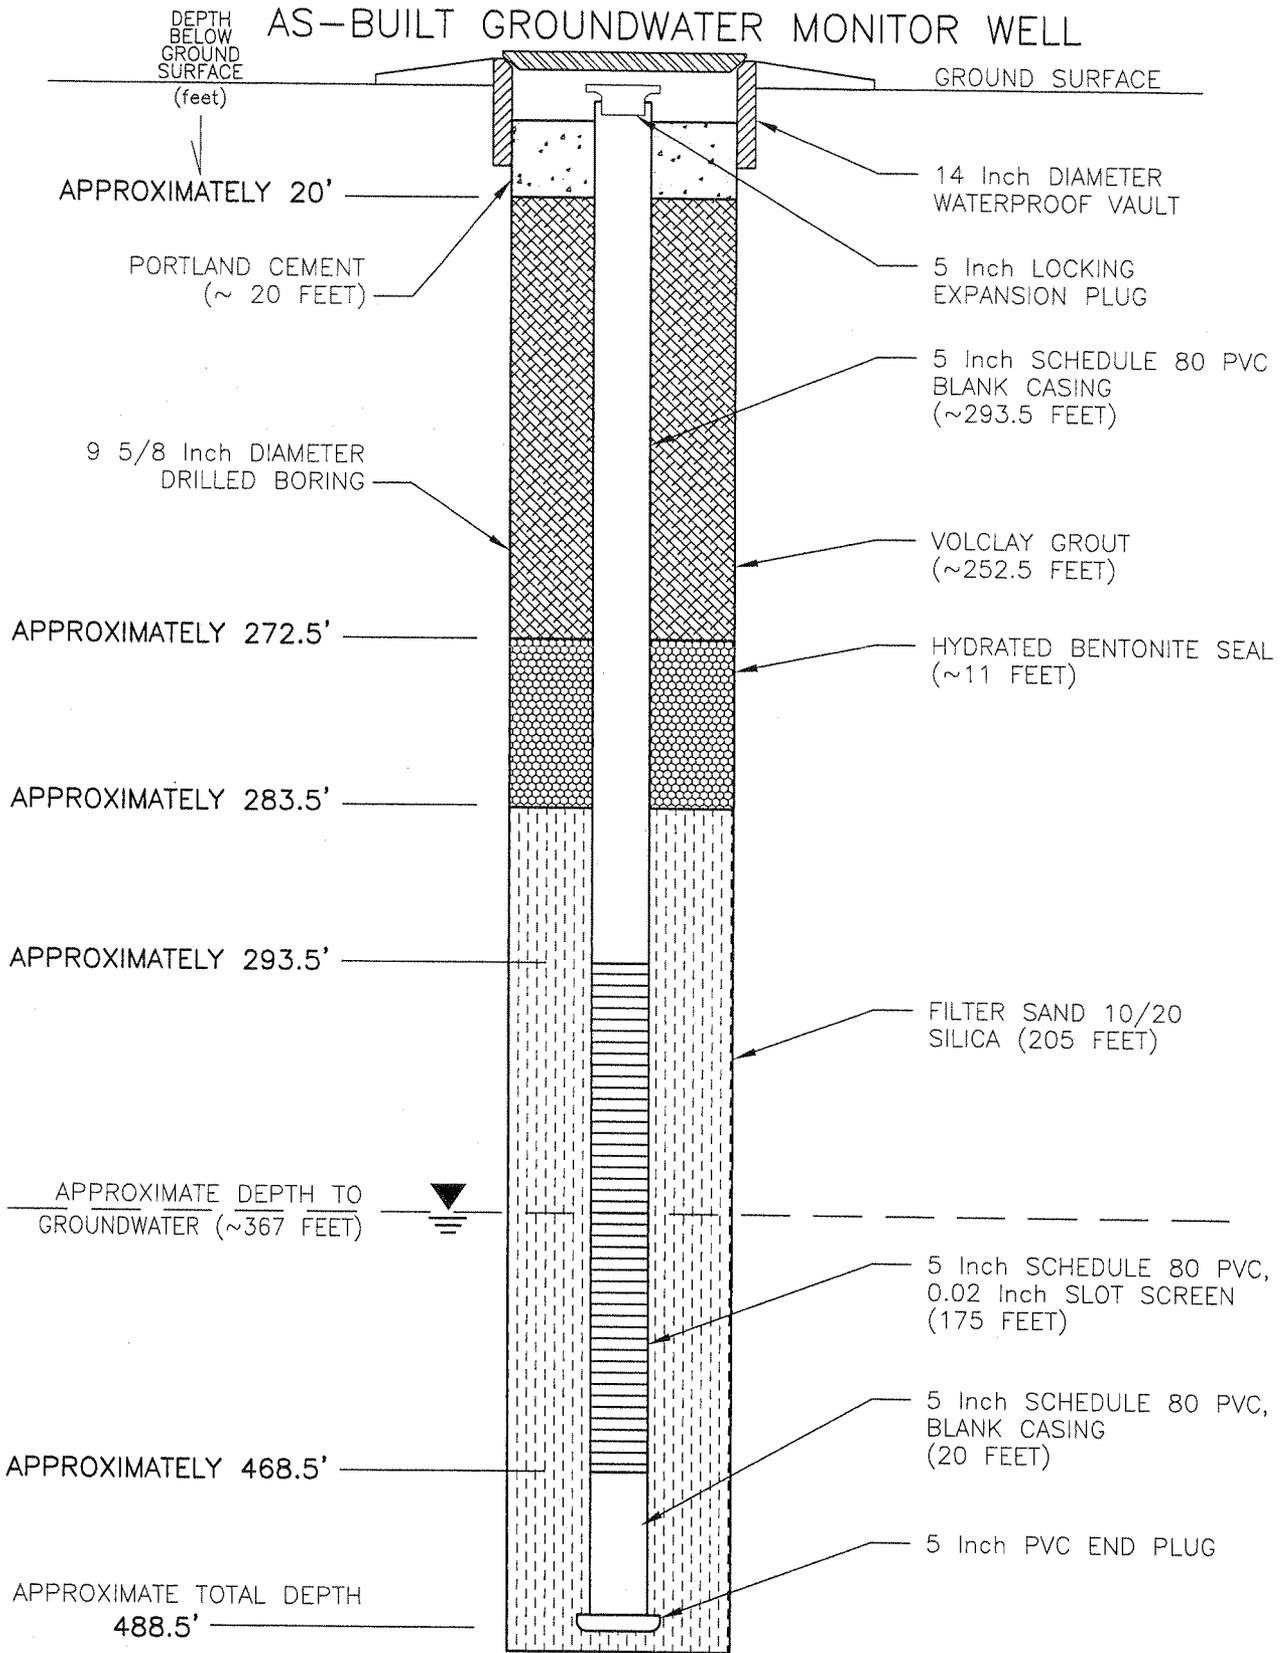


NOT TO SCALE

SECOR INTERNATIONAL
INCORPORATED
1830 WEST UNIVERSITY, SUITE 106
PHOENIX, ARIZONA 85281

WELL CONSTRUCTION DIAGRAM
(BP-15)
BROADWAY-PANTANO WQARF SITE
TUCSON, ARIZONA

FIGURE: **E-11**
DATE: 01/08/02
PROJECT NO:
018.20401.021

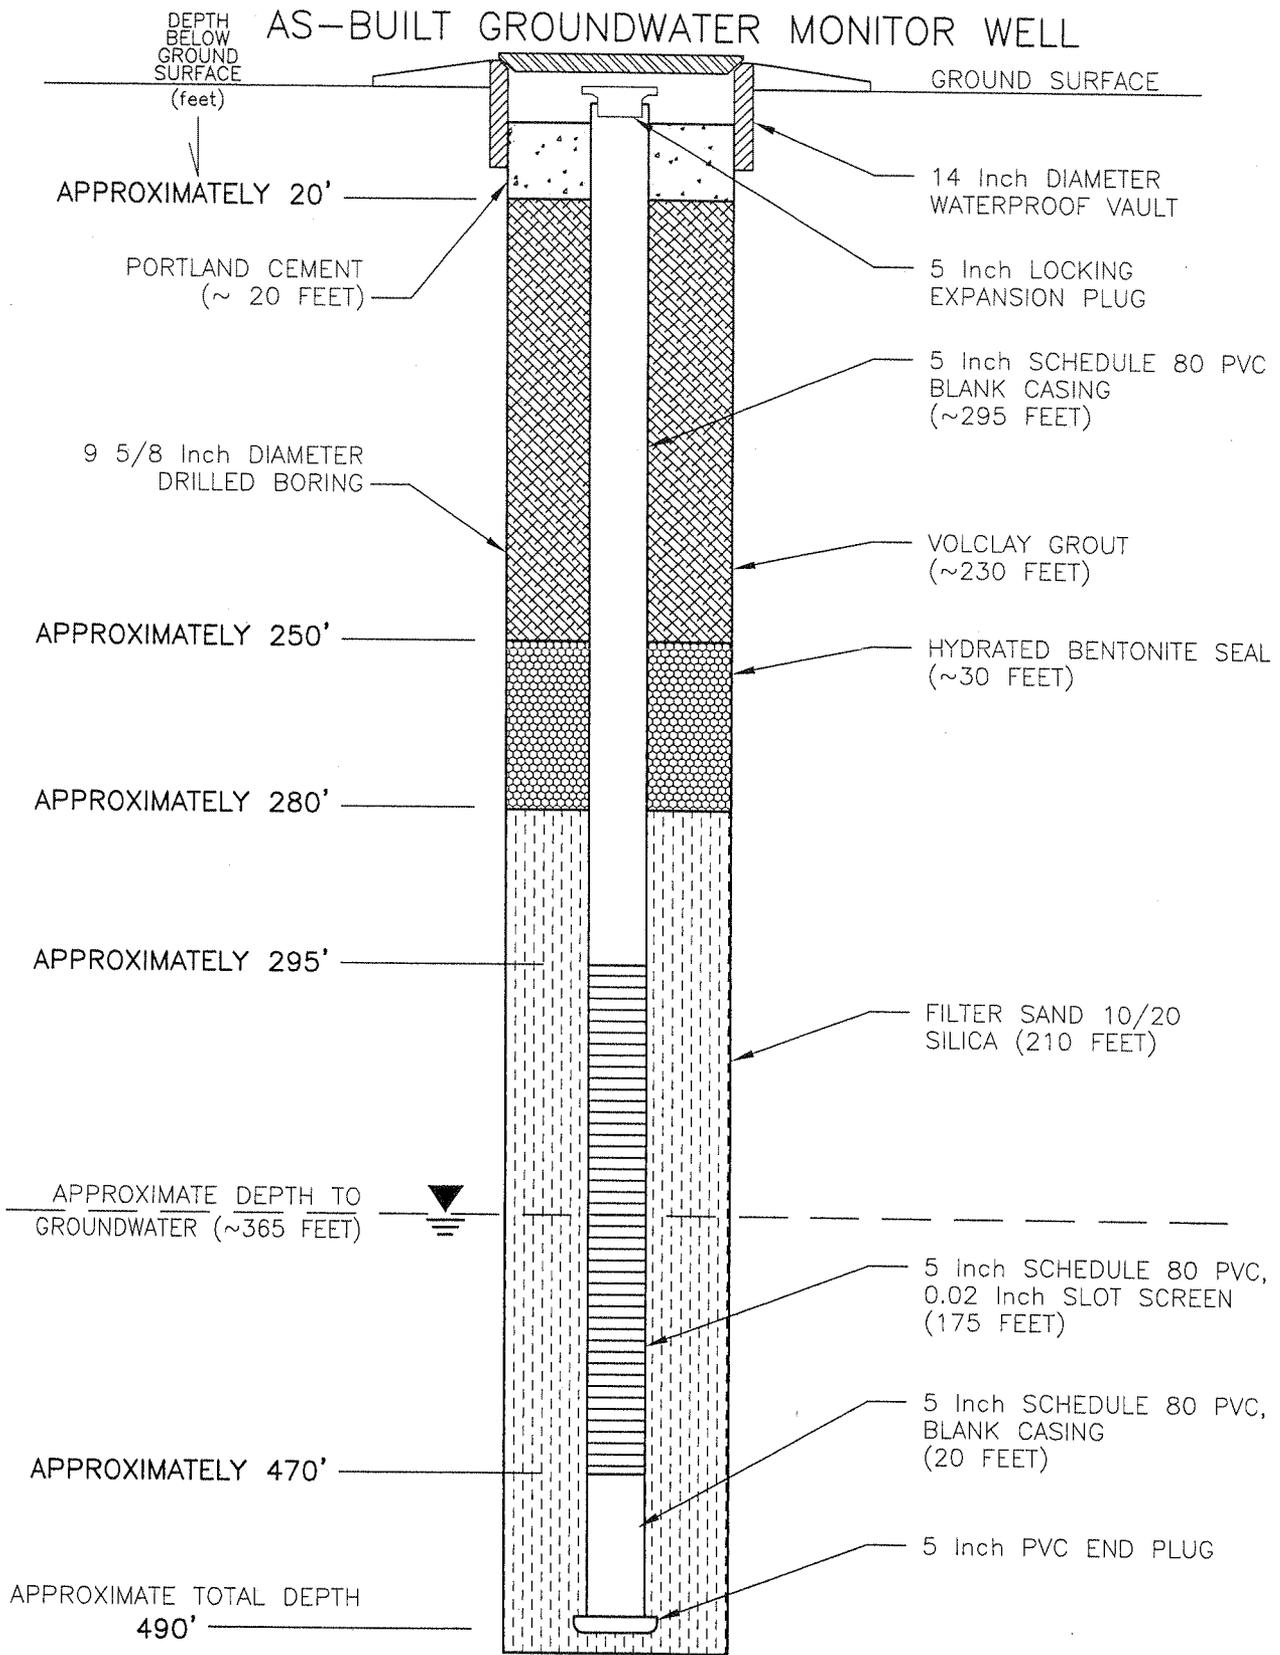


NOT TO SCALE

SECOR INTERNATIONAL
INCORPORATED
1830 WEST UNIVERSITY, SUITE 106
PHOENIX, ARIZONA 85281

WELL CONSTRUCTION DIAGRAM
(BP-16)
BROADWAY-PANTANO WQARF SITE
TUCSON, ARIZONA

FIGURE: **E-12**
DATE: 07/09/02
PROJECT NO:
180T.20401.00.0021

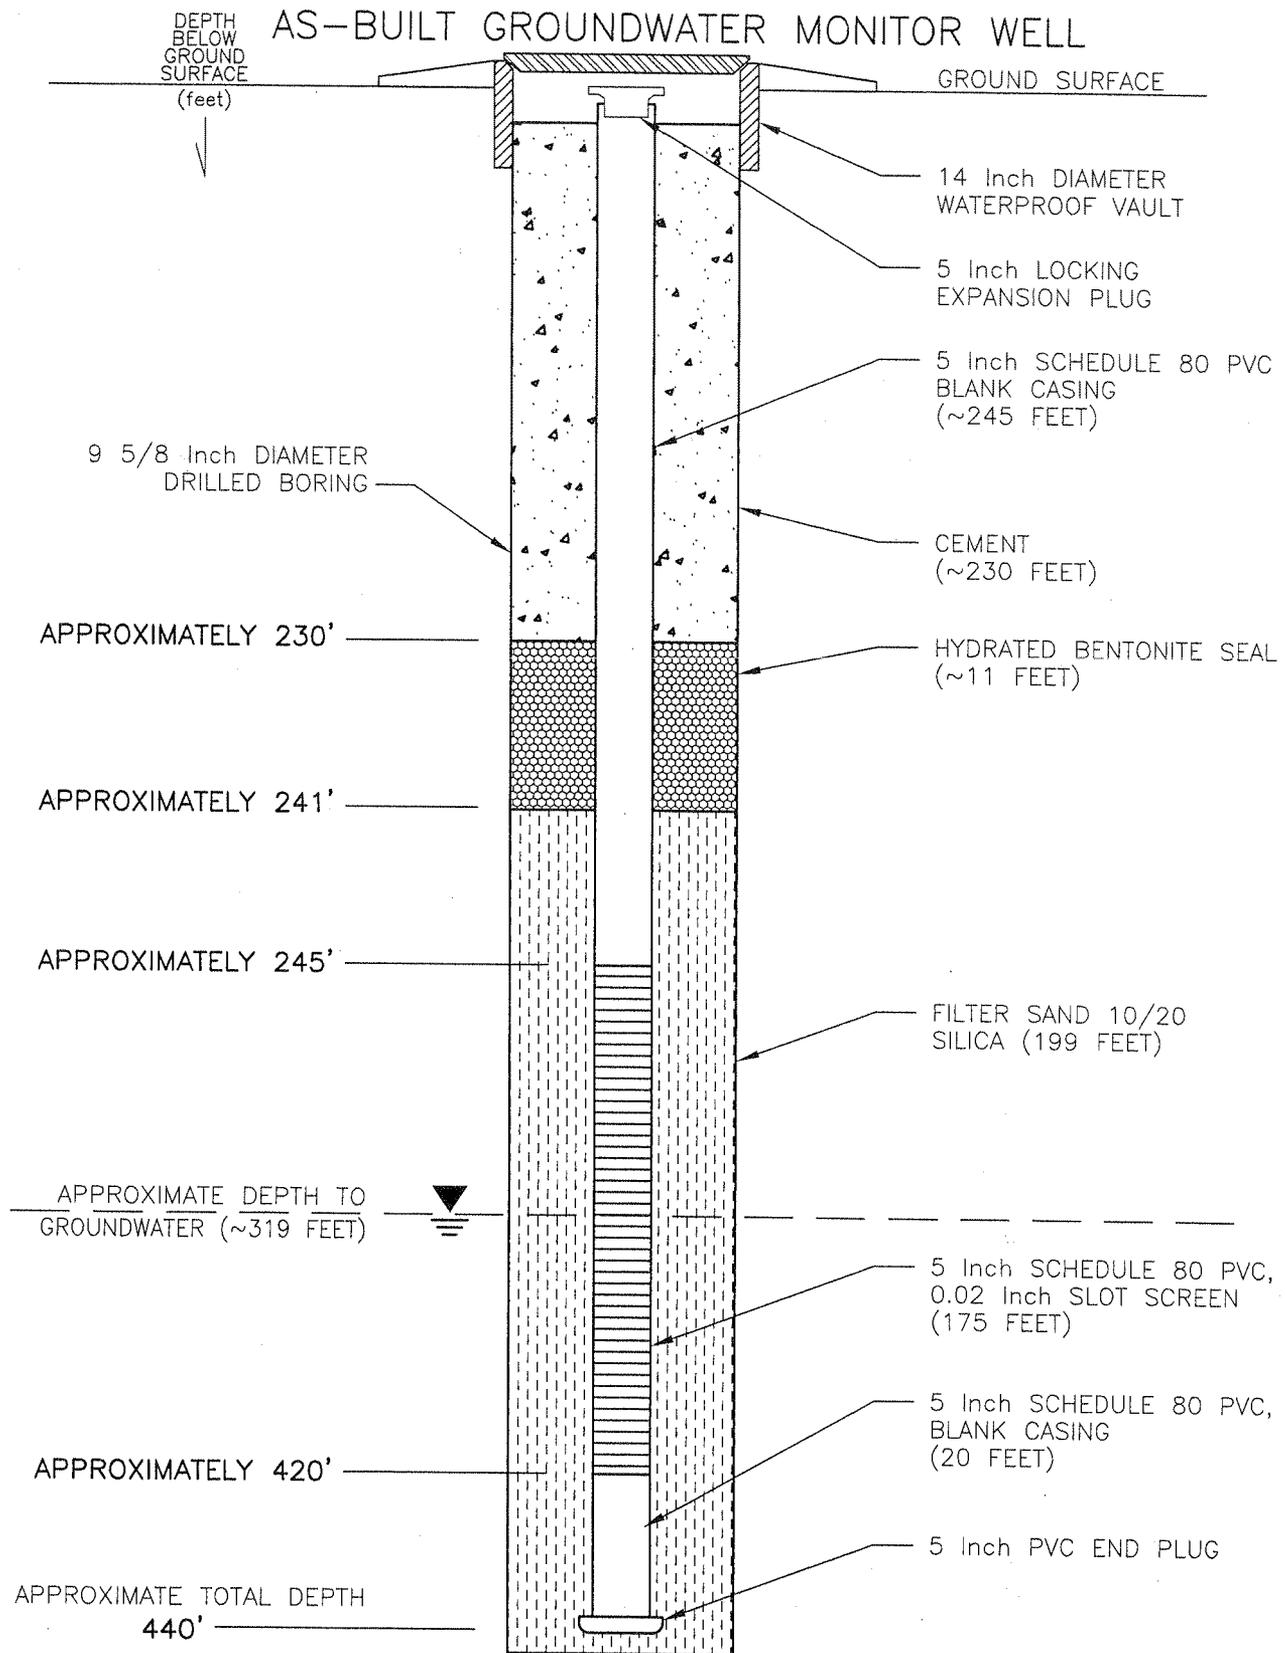

NOT TO SCALE

SECOR INTERNATIONAL INCORPORATED

1830 WEST UNIVERSITY, SUITE 106
PHOENIX, ARIZONA 85281

WELL CONSTRUCTION DIAGRAM
(BP-19)


BROADWAY-PANTANO WQARF SITE
TUCSON, ARIZONA

FIGURE: **E-13**

DATE: 02/18/03

PROJECT NO:
018.20401.021

**Project
File**

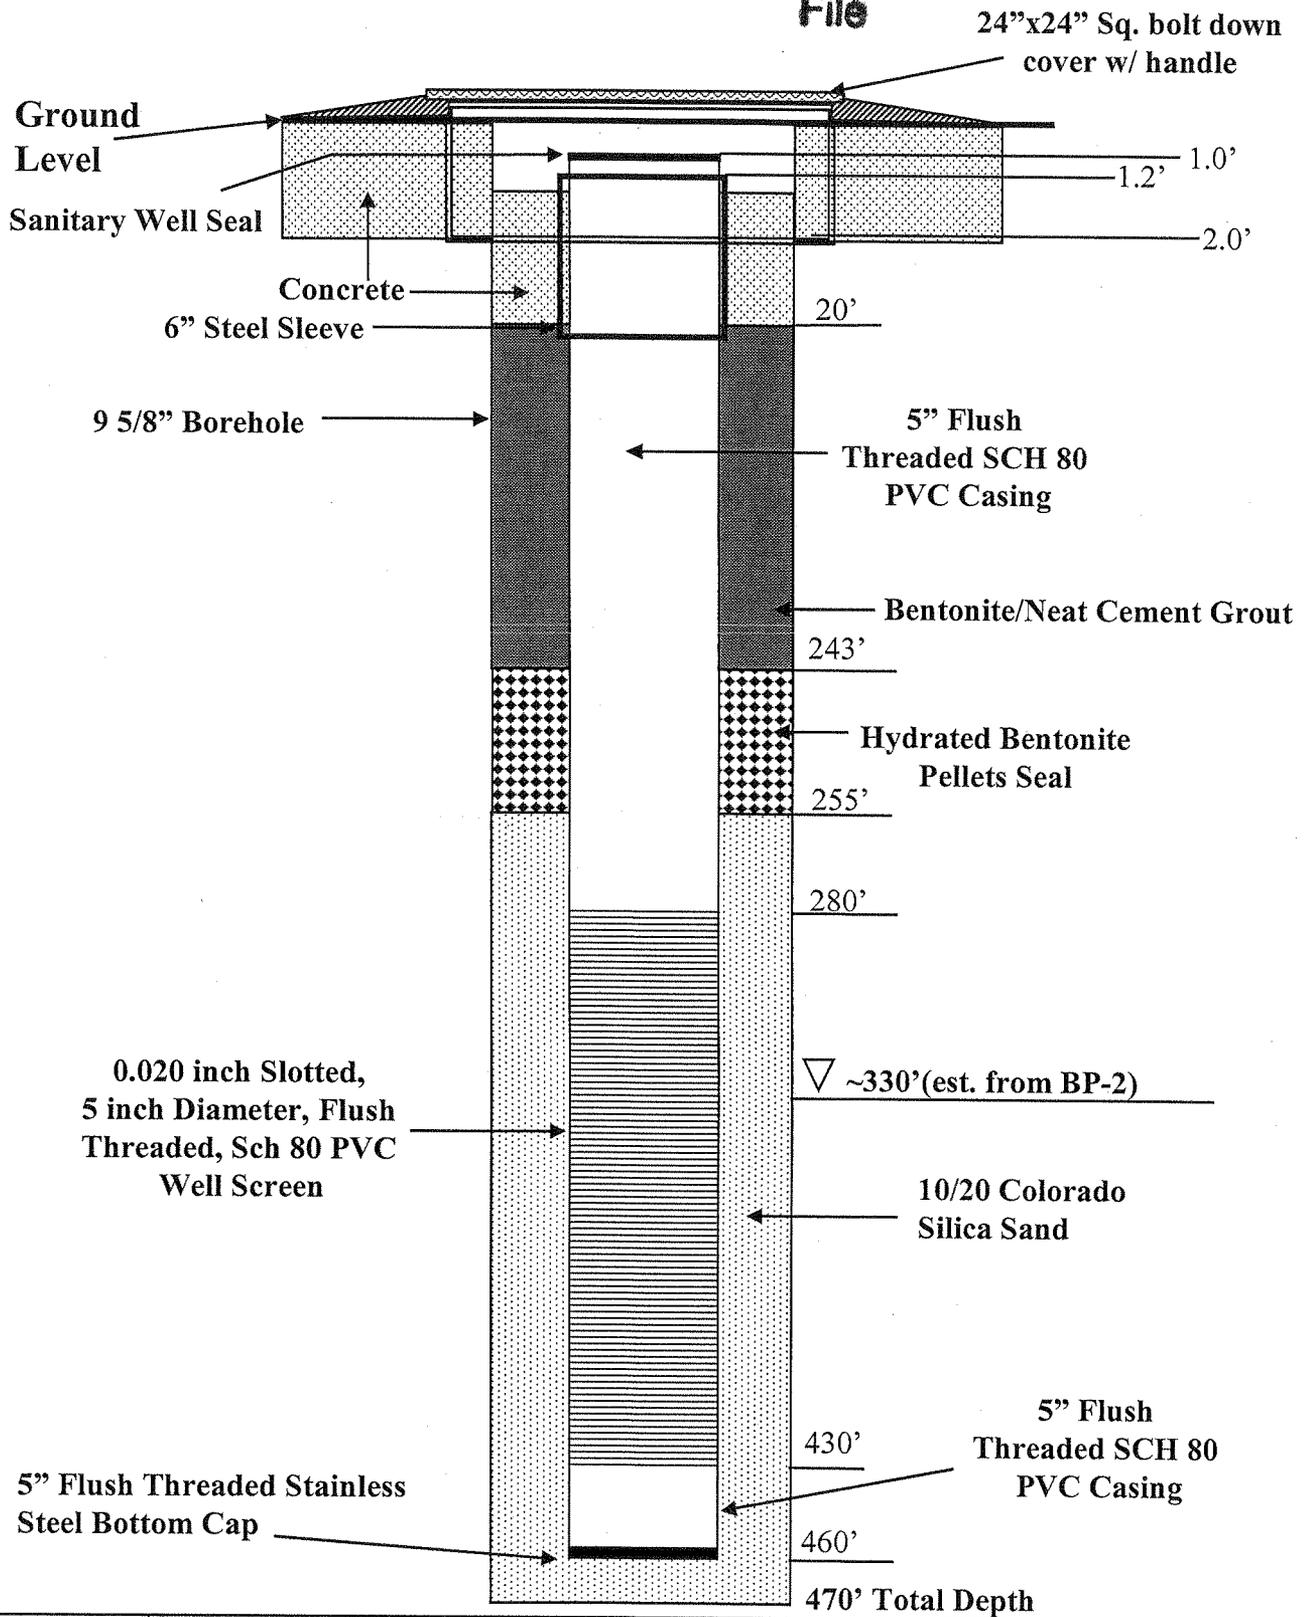


**Environmental
Services**

**Monitor Well BP-2
Broadway WQARF Area
As-Built**

Figure E-14


Project
File

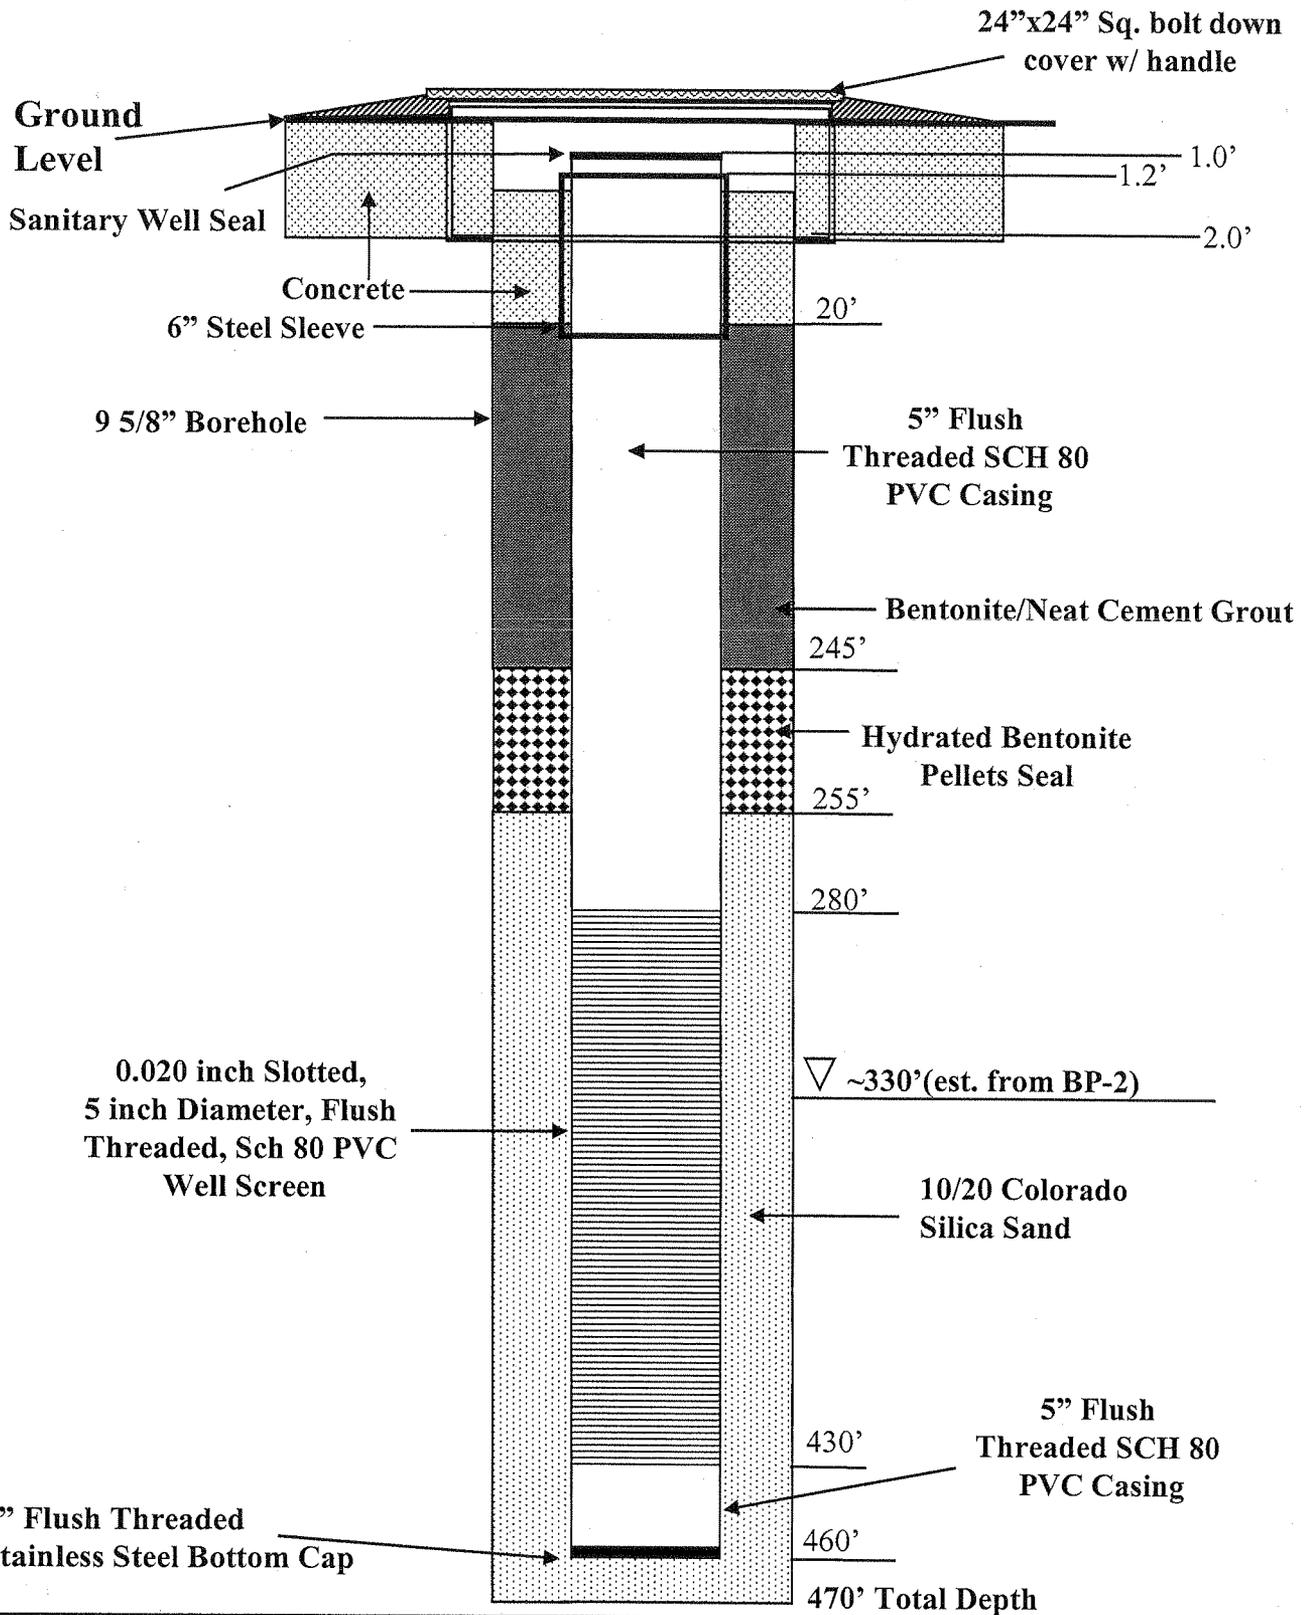

Environmental
Services

Monitor Well BP-21
Broadway WQARF Area
As-Built

Figure E-15

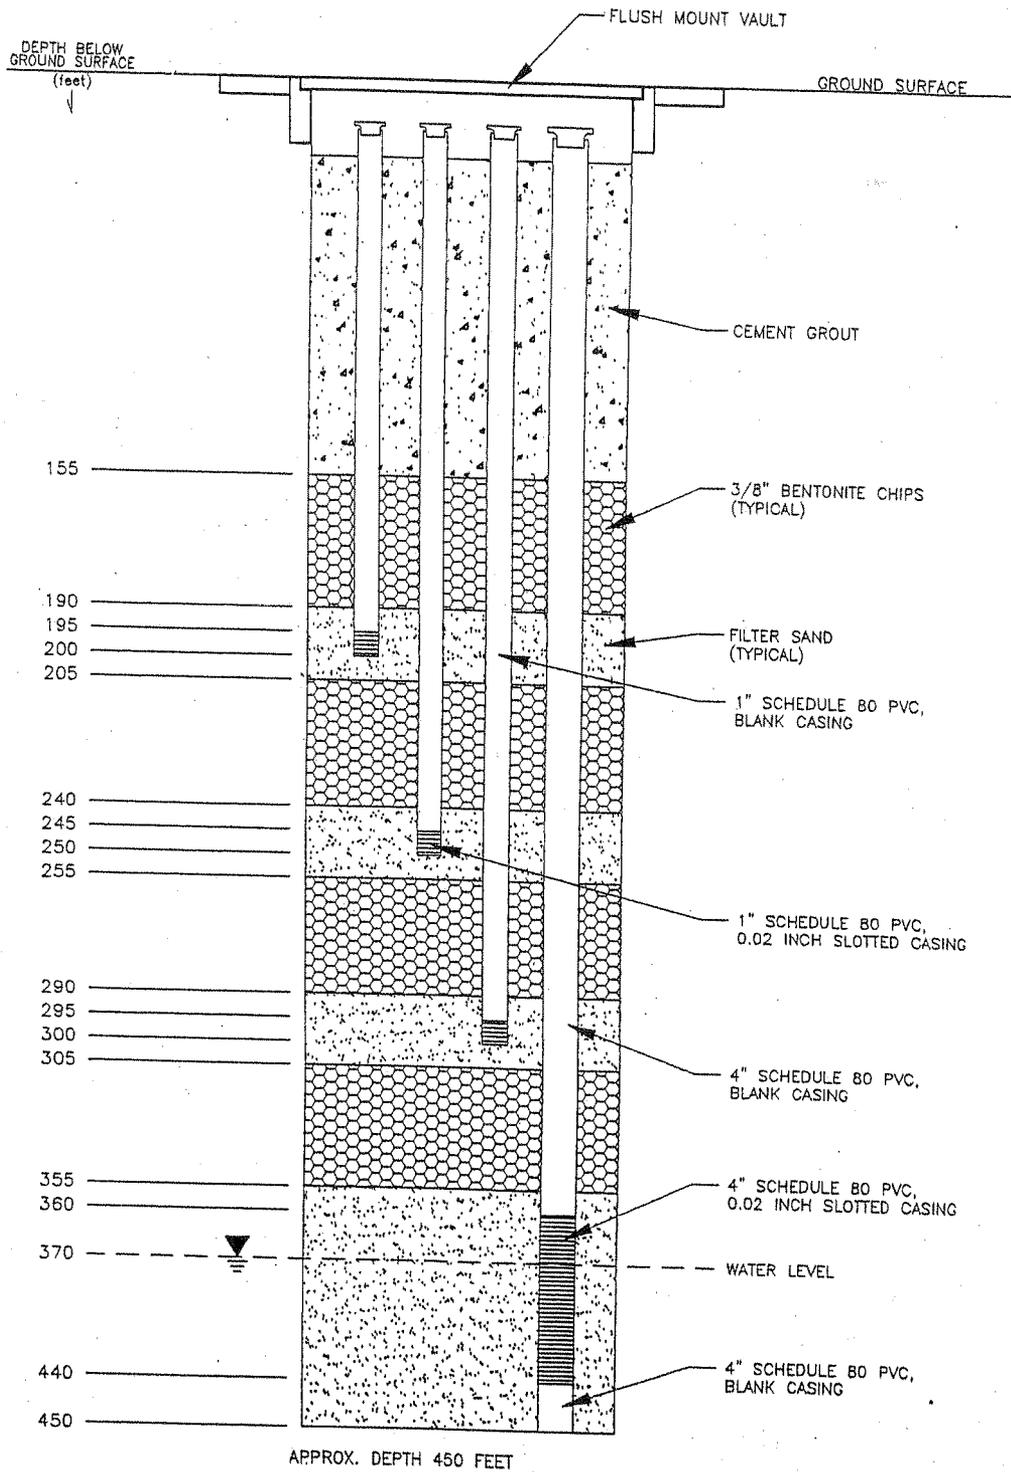

APPROX. DEPTH 450 FEET

No warranty is made by BECOR International, Inc. as to the accuracy, reliability, or completeness of these data. Original data were compiled from various sources. This information may not meet National Map Accuracy Standards. This product was developed electronically, and may be updated without notification. Any reproduction may result in a loss of scale and/or information.



1403 West 10th Place, Suite B-107
Tempe, Arizona 85281

PHONE: 480-804-1420 FAX: 480-804-1482

FOR:
BROADWAY-PANTANO
WQARF SITE
TUCSON, ARIZONA

BP-22
NESTED SOIL VAPOR/GROUNDWATER
MONITOR WELL SCHEMATIC DIAGRAM

FIGURE:
E-16

JOB NUMBER:
18QT.20401.06


DRAWN BY:
BDF

CHECKED BY:
TAK

APPROVED BY:
TAK

DATE:
03/14/2006

FILEPATH: \\ASRAC - BP (20401)\DWG\2040106_BP-22.dwg|bford|Mar 14, 2006 at 13:18|Layout: BP-22

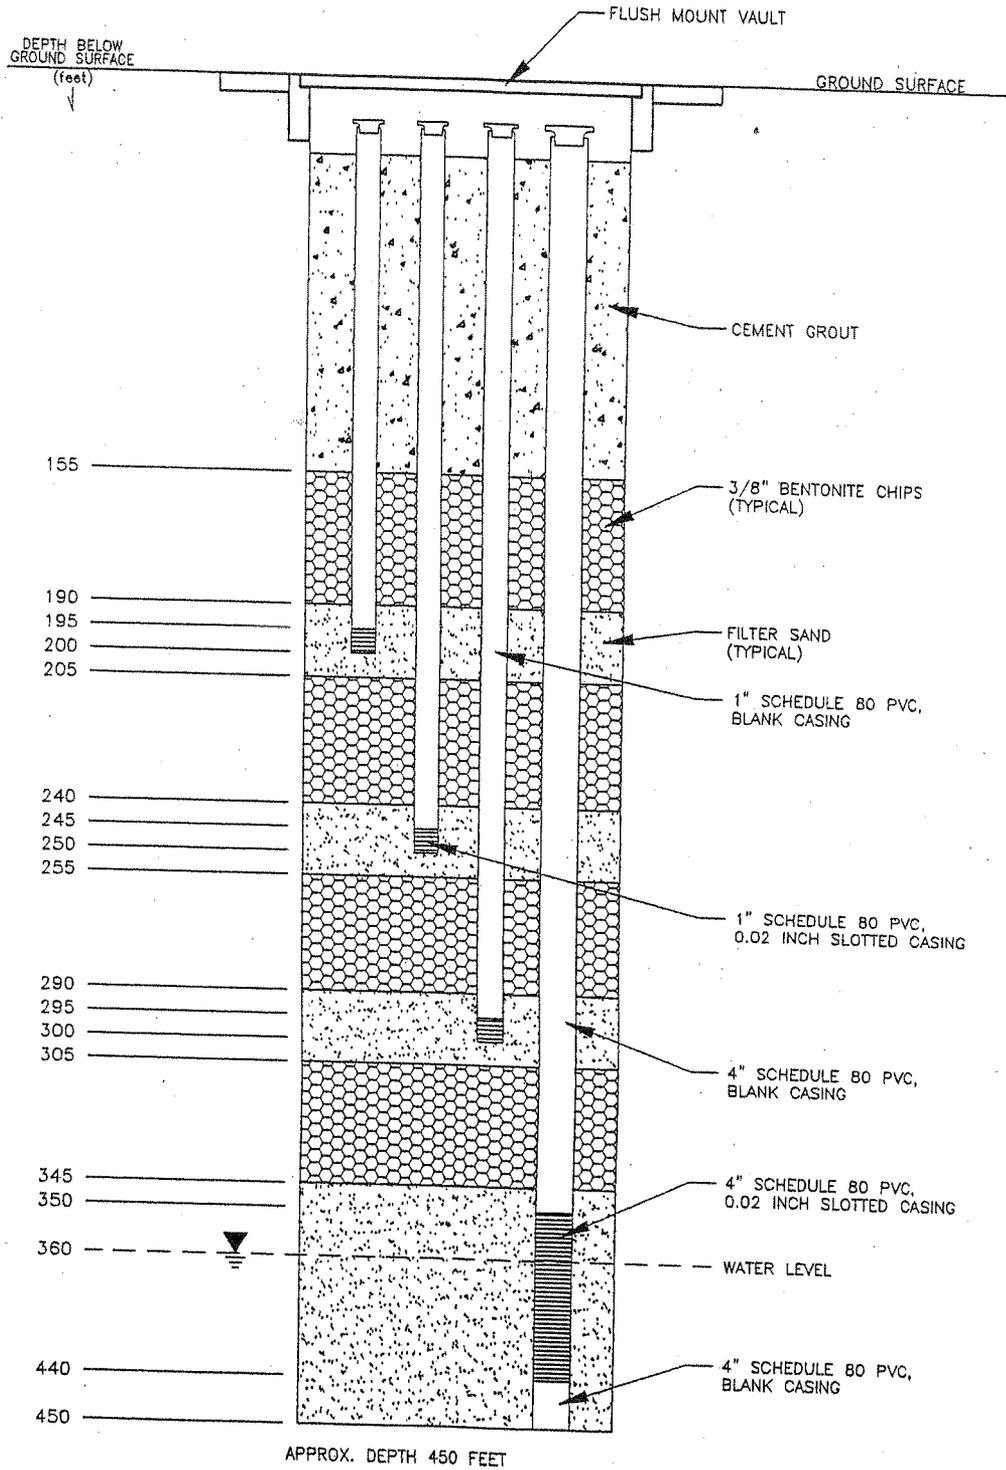

No warranty is made by SECOR International, Inc. as to the accuracy, reliability, or completeness of these data. Original data were compiled from various sources. This information may not meet National Map Accuracy Standards. This product was developed electronically, and may be updated without notification. Any reproduction may result in a loss of scale and/or information.




1403 West 10th Place, Suite B-107
Tempe, Arizona 85281

PHONE: 480-804-1420 FAX: 480-804-1482

FOR: BROADWAY-PANTANO WQARF SITE TUCSON, ARIZONA		BP-23 NESTED SOIL VAPOR/GROUNDWATER MONITOR WELL SCHEMATIC DIAGRAM		FIGURE: E-17
JOB NUMBER: 18OT.20401.06	DRAWN BY: BDF	CHECKED BY: TAK	APPROVED BY: TAK	DATE: 03/14/2008

FILEPATH: \\ASRAC - BP (20401)\DWG\2040106_BP-23.dwg|bford|Mar 14, 2008 at 13:20|Layout: BP-23

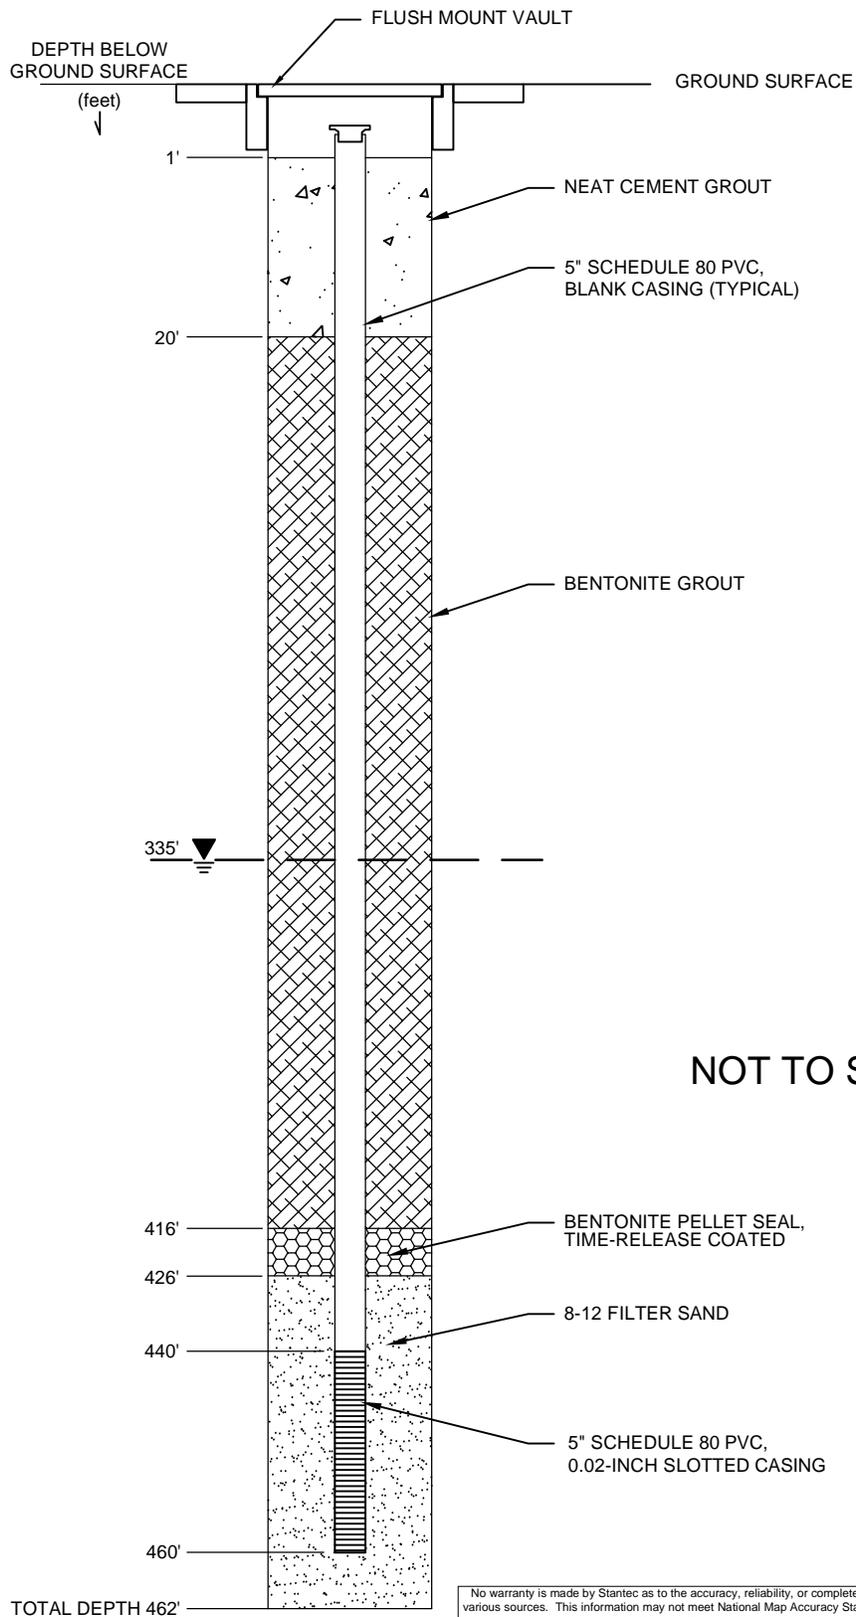

8211 S. 48th Street
Phoenix, Arizona

PHONE: (602) 438-2200 FAX: (602) 431-9562

FOR:
BROADWAY - PANTANO
WQARF SITE
TUCSON, ARIZONA

AS-BUILT BP-24C GROUNDWATER
MONITORING WELL
SCHEMATIC DIAGRAM

FIGURE:
E-18


JOB NUMBER:
18OT.20401.08

DRAWN BY:
KJG

CHECKED BY:
TAK

APPROVED BY:
TAK

DATE:
7/30/2008

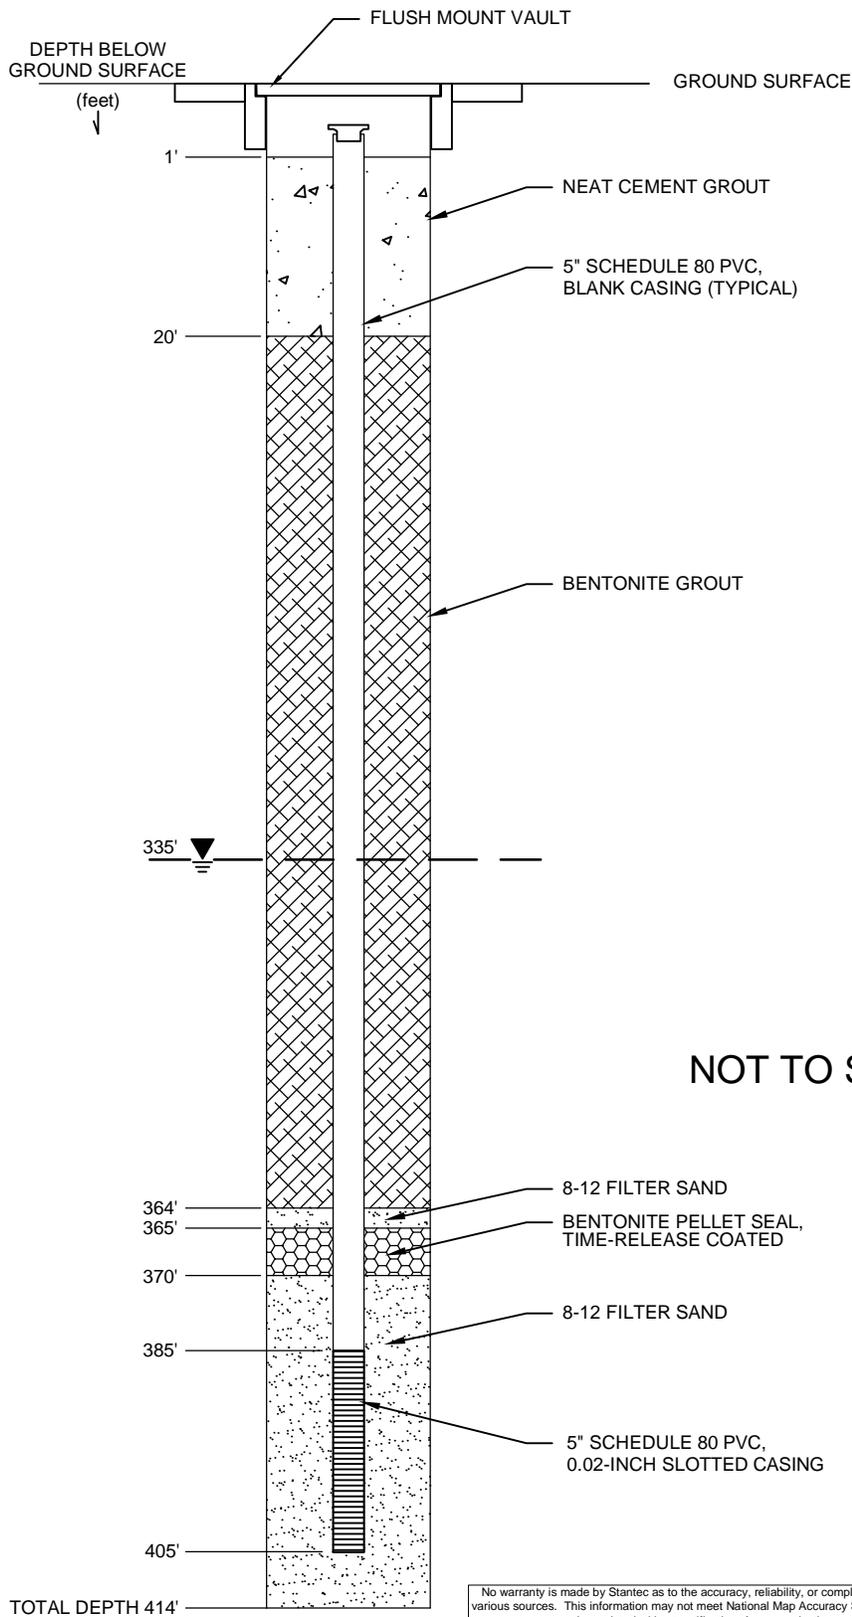

8211 S. 48th Street
Phoenix, Arizona

PHONE: (602) 438-2200 FAX: (602) 431-9562

FOR:
BROADWAY - PANTANO
WQARF SITE
TUCSON, ARIZONA

AS-BUILT BP-24B GROUNDWATER
MONITORING WELL
SCHEMATIC DIAGRAM

FIGURE:
E-19


JOB NUMBER:
18OT.20401.08

DRAWN BY:
KJG

CHECKED BY:
TAK

APPROVED BY:
TAK

DATE:
7/30/2008

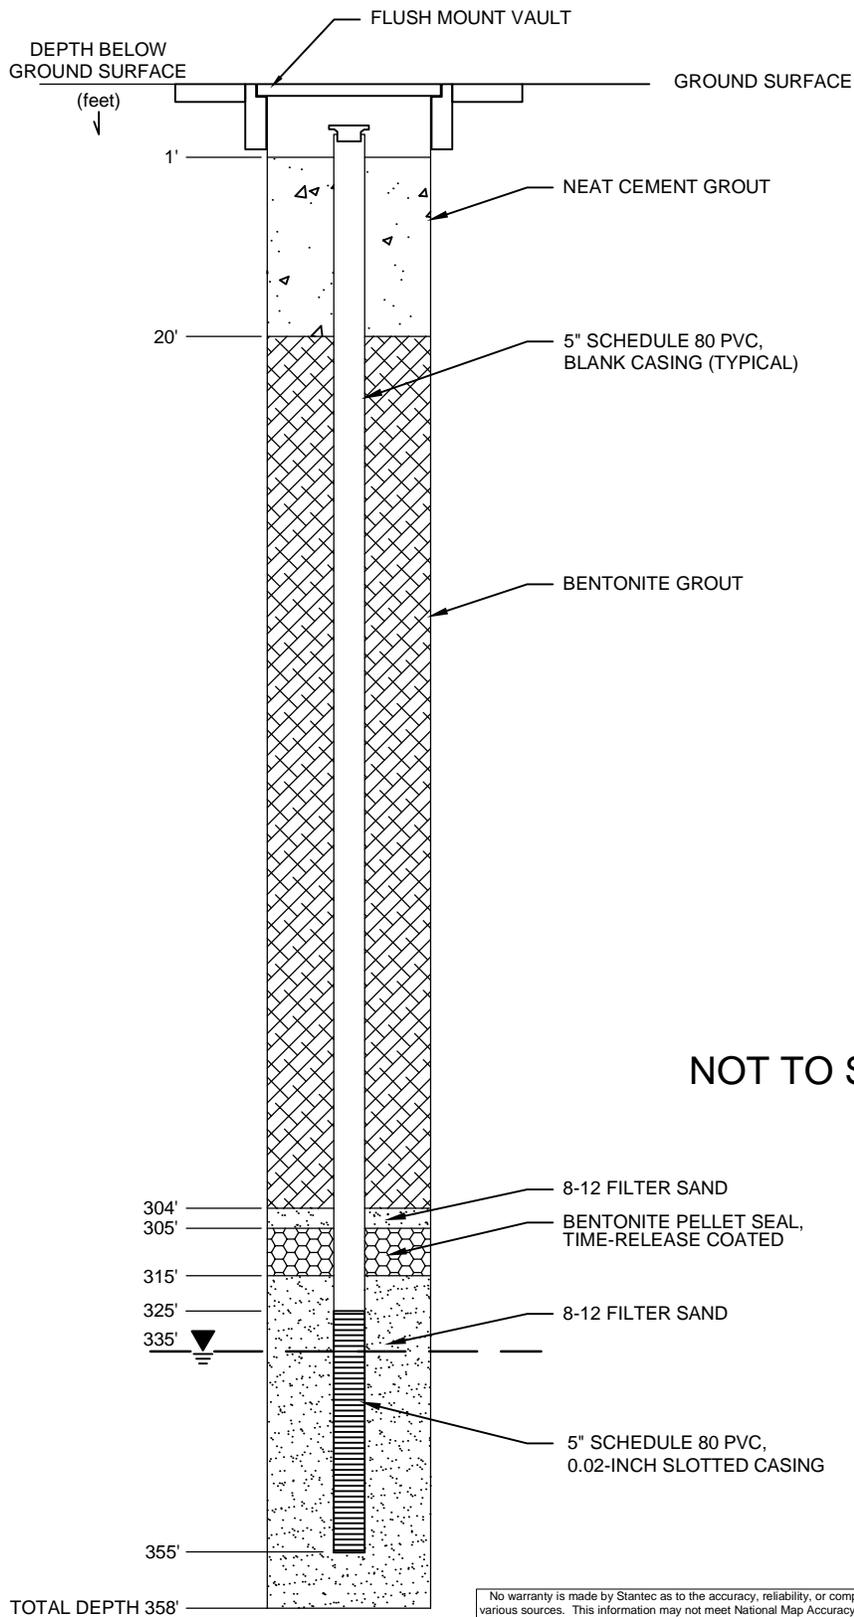

8211 S. 48th Street
Phoenix, Arizona

PHONE: (602) 438-2200 FAX: (602) 431-9562

FOR:
BROADWAY - PANTANO
WQARF SITE
TUCSON, ARIZONA

AS-BUILT BP-24A GROUNDWATER
MONITORING WELL
SCHEMATIC DIAGRAM

FIGURE:
E-20


JOB NUMBER:
18OT.20401.08

DRAWN BY:
KJG

CHECKED BY:
TAK

APPROVED BY:
TAK

DATE:
7/30/2008

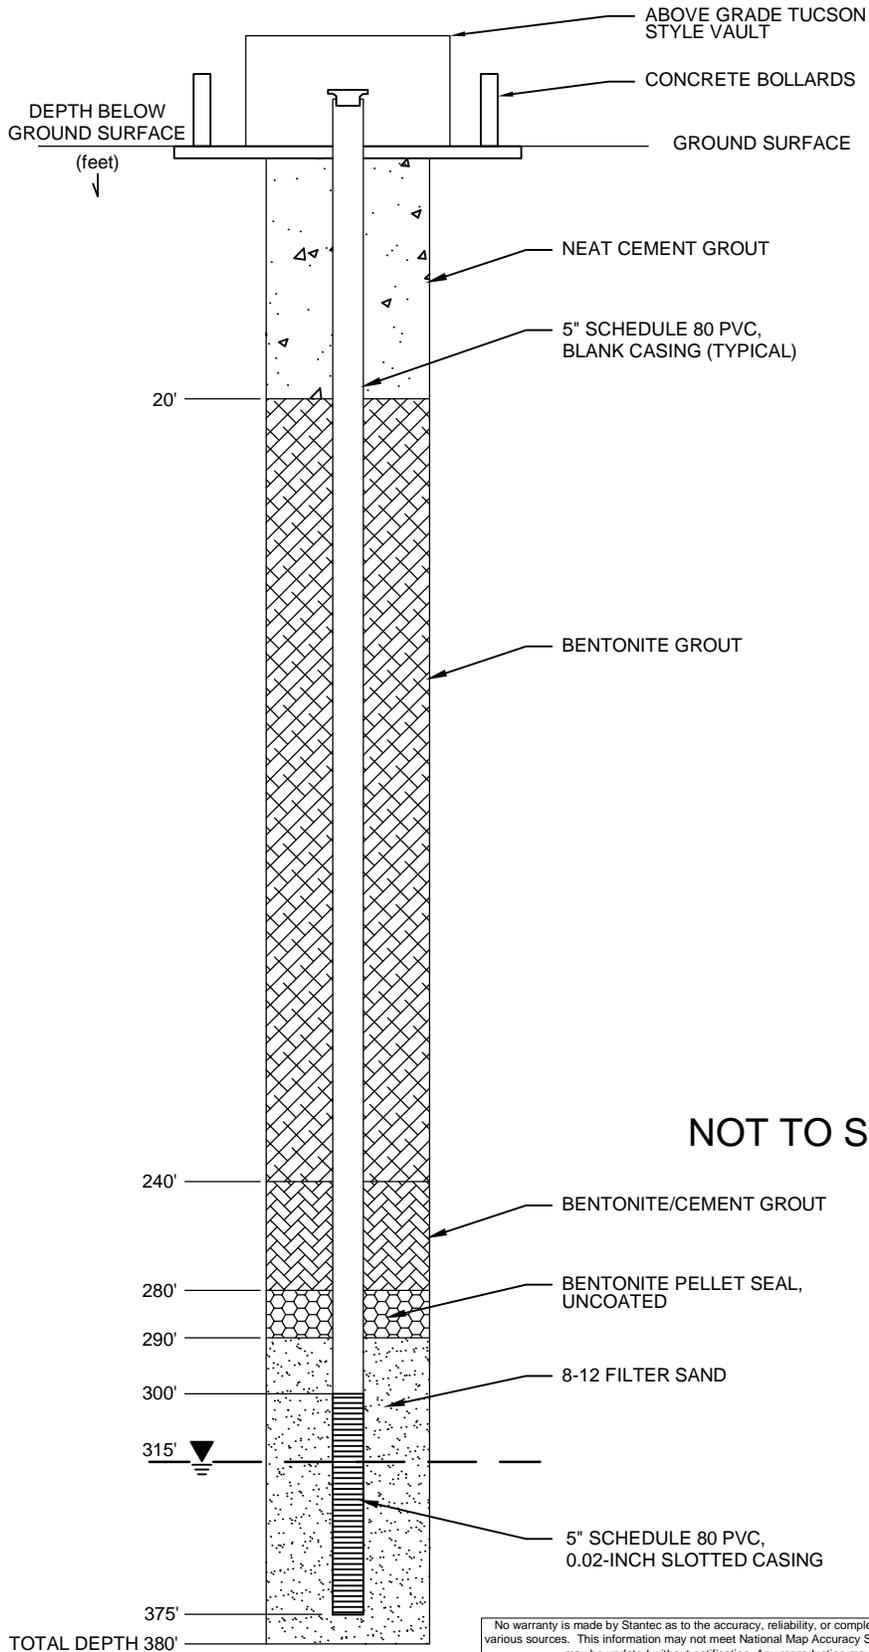

Stantec

8211 S. 48th Street
Phoenix, Arizona

PHONE: (602) 438-2200 FAX: (602) 431-9562

FOR:
BROADWAY - PANTANO
WQARF SITE
TUCSON, ARIZONA

AS-BUILT BP-25 GROUNDWATER
MONITORING WELL
SCHEMATIC DIAGRAM

FIGURE:

E-21

JOB NUMBER:
18OT.20401.08

DRAWN BY:
KJG

CHECKED BY:
TAK

APPROVED BY:
TAK

DATE:
7/30/2008