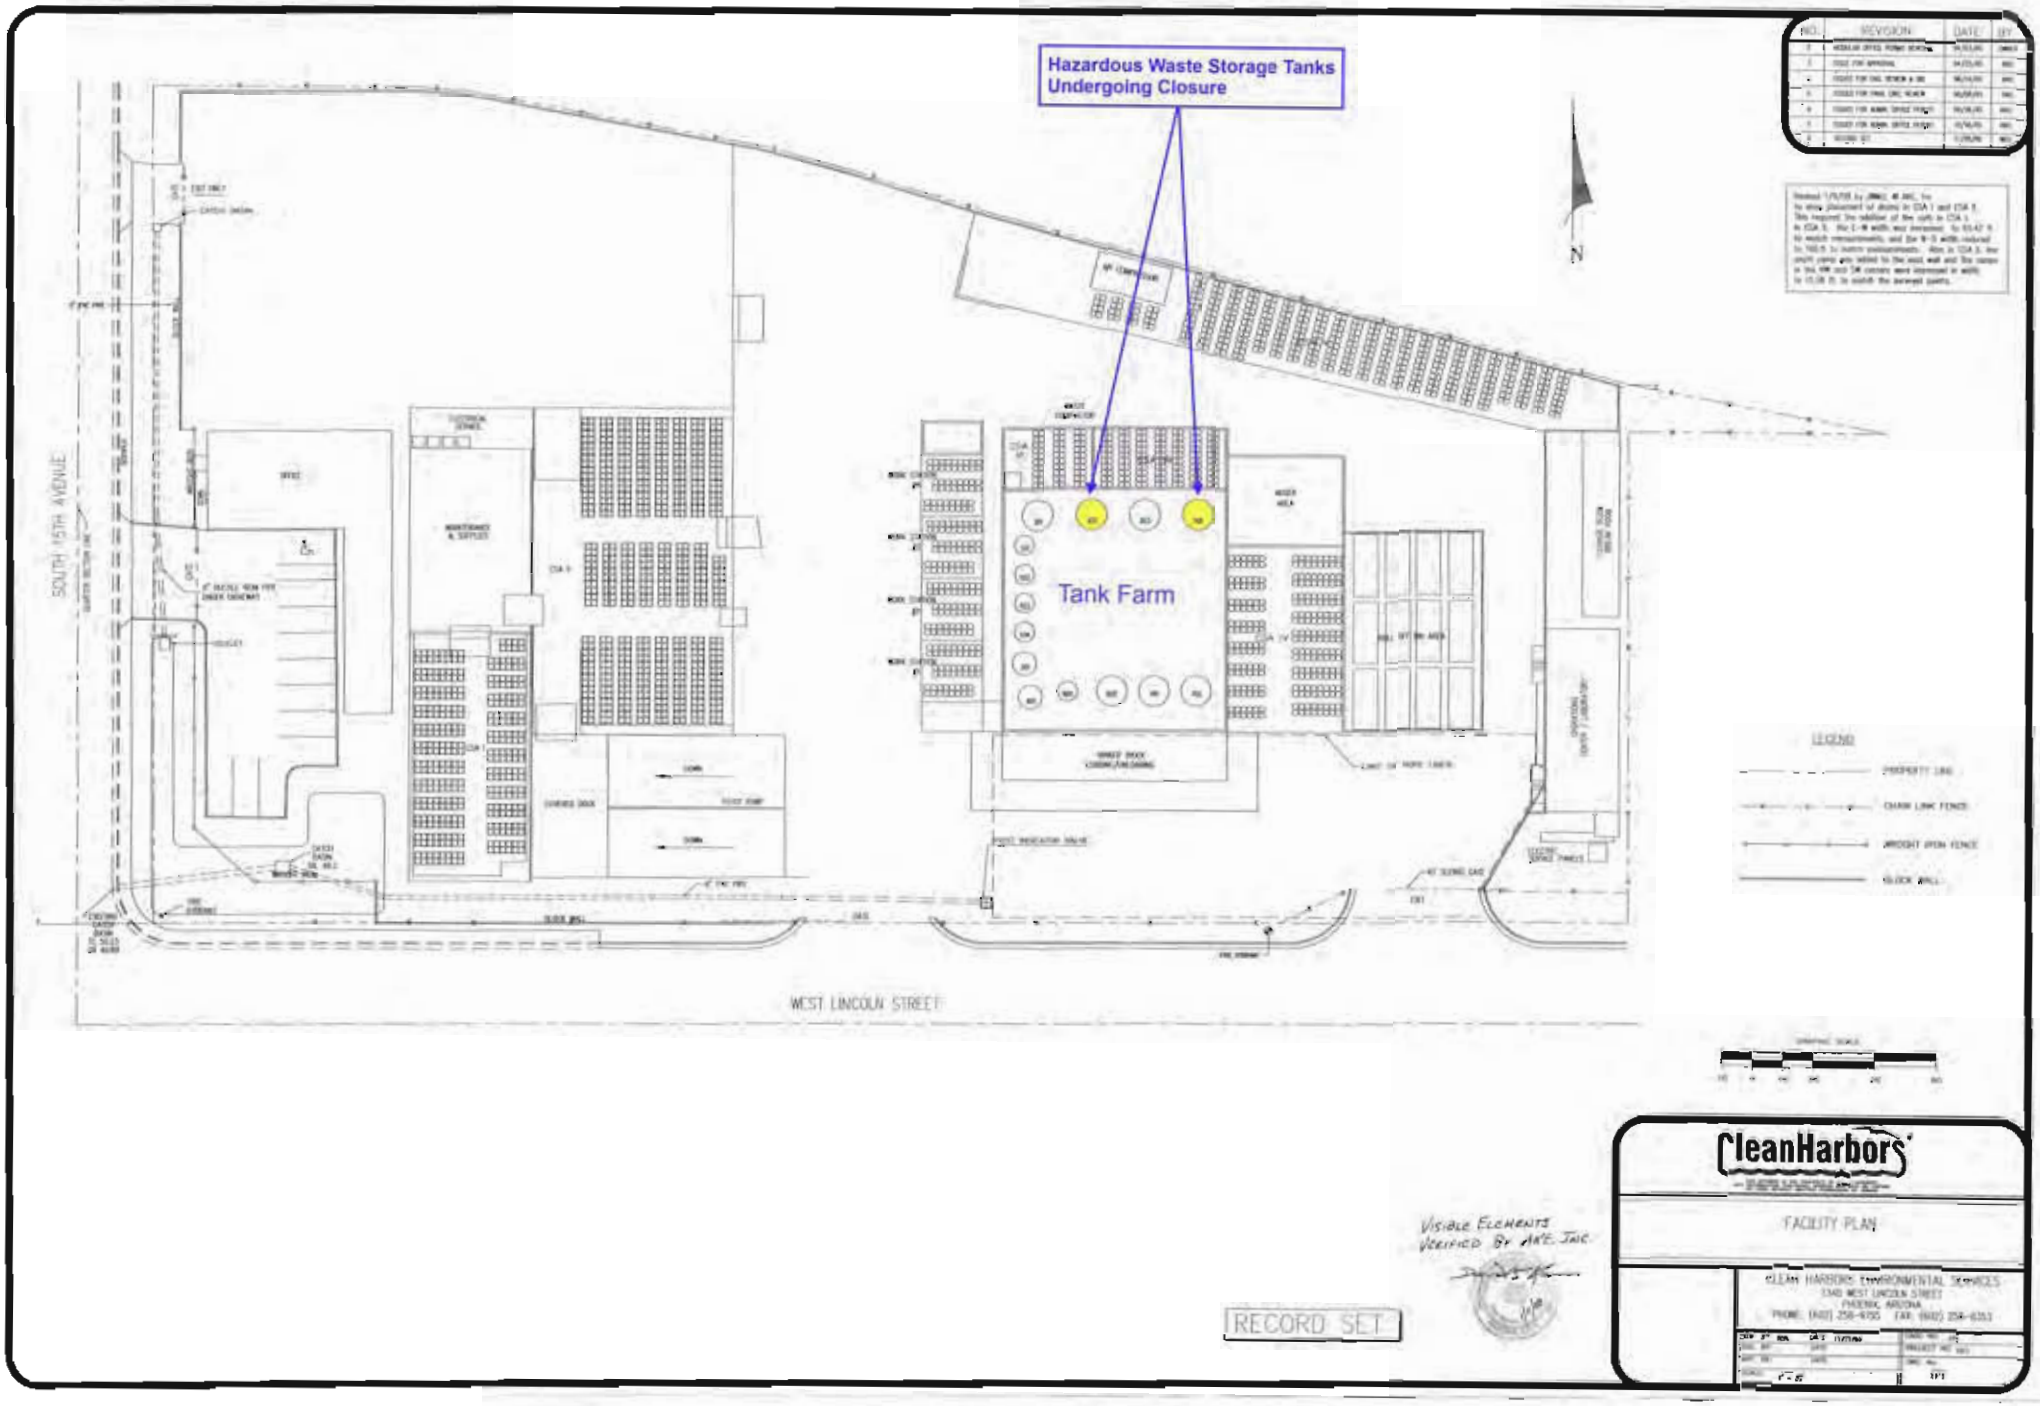
Hazardous Waste Storage Tanks
Undergoing Closure
Tank Farm
SOUTH 15TH AVENUE
WEST LINCOLN STREET
N
LEGEND
PROPERTY LINE
CHAIN LINK FENCE
WROUGHT IRON FENCE
CLOCK WALL
CleanHarbors
FACILITY PLAN
CLEAN HARBORS ENVIRONMENTAL SERVICES
1340 WEST LINCOLN STREET
PHOENIX, ARIZONA
RECORD SET
VISIBLE ELEMENTS
VERIFIED BY A.R.E. INC